IREDELL COUNTY HEALTH DEPARTMENT

STATESVILLE 704-878-5305 (CV) MOORESVILLE 704-664-5281

IMPROVEMENT PERMIT / AUTHORIZATION TO CONSTRUCT / OPERATION PERMIT / EXISTING SYSTEM INSPECTION

PERMIT# 110695 PIN# 4752-52-3183 DATE 02/20/03

OWNER OR CONTRACTOR VINCENT HENRY PHONE: Business 516-887-7749 ~~Home~~ 704-450-3076 BRENDA JORDAN

ADDRESS 117 OLD MOUNTAIN RD. STATESVILLE, NC 28677

LOCATION HWY 70 EAST, (R) SHILOH RD., (R) FAITH + HOPE LN., @ END.

SUBDIVISION — BLOCK / SECTION — LOT — LOT AREA 3.59 ACRES SITE CLASS. PS DESIGN FLOW 480 GPD L.T.A.R. 0.35 GPD/FT²

Septic Tank: 1,000 Gallons; STB 354 Date 7-15-03
Pump Tank: ____ Gallons; PT ____ Date ____
Pump Make: ____ Model ____ Serial No. ____
Nitrification Field: No Fields 1 Square Feet 1,380 Linear Feet 460
No Lines 5 @ 92' Trench Width 36" Max Trench Bottom Depth 36" Gravel Depth 12"

☒ New System ☐ Repair System Type: I, (II), III, IV, V, VI
System Description: CONVENTIONAL, GRAVITY
Repair System Description: SAME
Maintenance Agreement Required: ☐ Yes ☒ No


☒ House/Mod. Home No. Bedrooms 4
☐ Mobile Home No. Bathrooms 3½
☐ Business No. Employees ____
☐ Other ____
☐ Slab ☒ Crawl Space ☐ Basement w/plumbing ☐ Basement wo/plumbing

Water Supply: ☒ Individual ☐ Public ☐ Community
NEW/EXISTING? WELL


Comments/Conditions: (1) SEPTIC SYSTEM MUST BE 100' PLUS FROM ANY WELL (15A NCAC 18A .1956 (6)(a)).

Comments/Conditions: SEPTIC TANK WITH MARKER INSTALLED USING "POLY LOK" FILLER

INITIAL SITE SKETCH

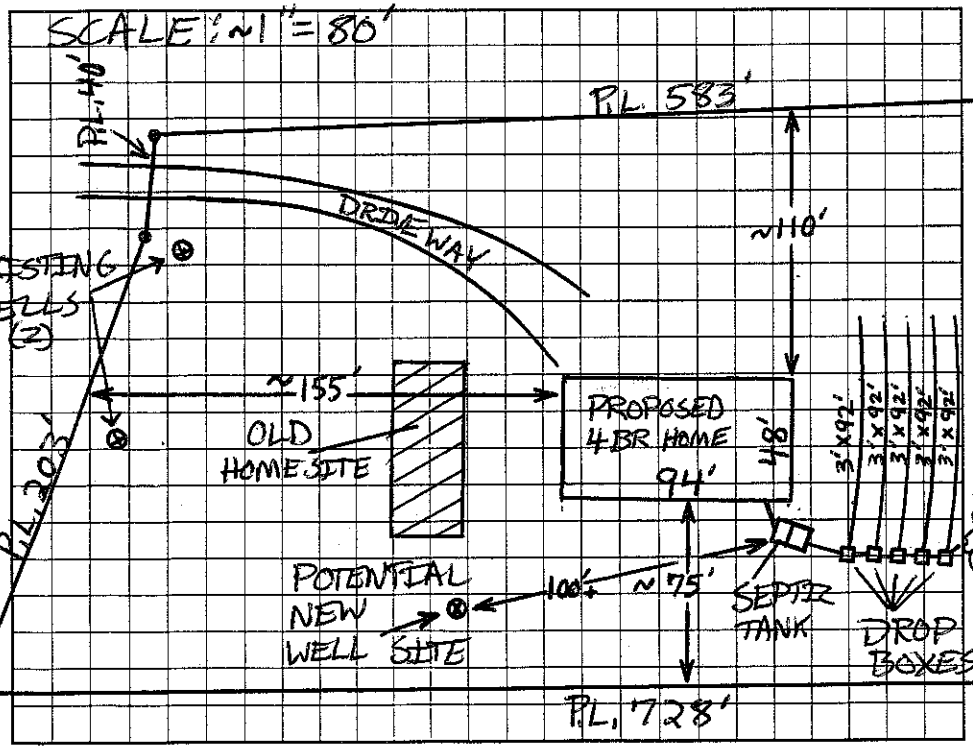

AS BUILT SKETCH

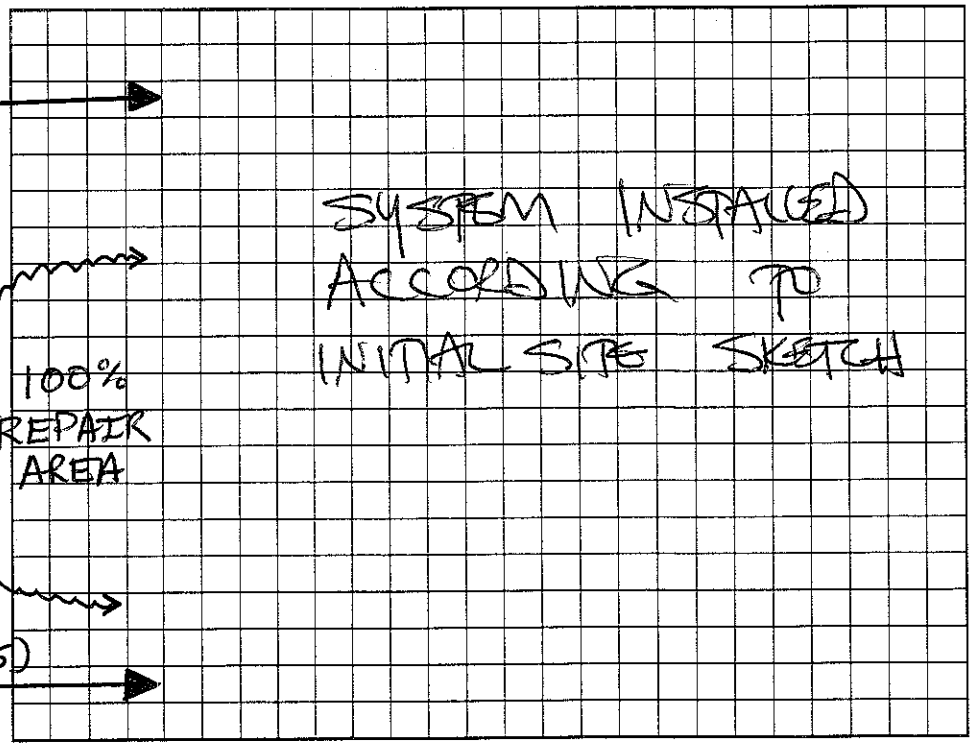

Permit can be suspended or revoked if any false information is supplied toward securing the permit/any unauthorized changes are made to the site/any unauthorized changes are made in the installation of the system. Improvement Permit with plat valid without expiration. Improvement Permit with site plan valid for sixty months. Authorization to Construct is valid for a period equal to that of Improvement Permit – not to exceed sixty months.

Signed Brenda Jordan date 2/21/03 Installed by: G & M ENTERPRISE

Improvement Permit by: Patrick Mitchell date 02/20/03 Operation Permit by: STEVE HENDRICK date 8-20-03

Authorization to Construct by: Patrick Mitchell date 02/20/03 Existing System Inspection by: ____ date ____

HEALTH DEPT. COPY: WHITE OWNER COPY (FINAL): YELLOW OWNER COPY (INITIAL): PINK