IREDELL COUNTY HEALTH DEPARTMENT

STATESVILLE 704-878-5305 MOORESVILLE 704-664-5281

IMPROVEMENT PERMIT / AUTHORIZATION TO CONSTRUCT / OPERATION PERMIT / EXISTING SYSTEM INSPECTION

PERMIT# 89871 PIN# 4752529047 DATE June 16, 2000

OWNER OR CONTRACTOR PATRANA SISONRATH PHONE: Business _____ Home 663 0174

ADDRESS 514 Boger St Mooresville NC

LOCATION Hwy 70 W (R) Shiloh (R) Faith + Hope To end on Right

SUBDIVISION Ray Current BLOCK / SECTION _____ LOT 1 LOT AREA .98 SITE CLASS. P5 DESIGN FLOW 480 L.T.A.R. .3

Septic Tank: 1000 Gallons; STB 1012 Date 5-28-00 ☒ New System ☐ Repair System Type: I, II, III, IV, V, VI

Pump Tank: _____ Gallons; PT _____ Date _____ System Description: GRAVITY 25% Reduction

Pump Make: _____ Model _____ Serial No. _____ Repair System Description: " 50% Reduction

Nitrification Field: No Fields 1 Square Feet 1650 Linear Feet 400 Maintenance Agreement Required: ☐ Yes ☒ No

No Lines 4 Trench Width 36" Max Trench Bottom Depth 36" Gravel Depth 12" ☐ Slab ☒ Crawl Space ☐ Basement w/plumbing ☐ Basement wo/plumbing

☒ House/Mod. Home No. Bedrooms 4

☐ Mobile Home No. Bathrooms 3

☐ Business No. Employees _____


☐ Other _____

Water Supply: ☒ Individual ☐ Public ☐ Community WELL


Comments/Conditions: INSTALL on CONTOUR
Keep well 100ft or MAX FEASIBLE distance from Septic System (50ft min.)
67 Chambers or 40 HDS sections
permit issued using property corners shown by owner

Comments/Conditions: SEPTIC TANK W/ RISERS INSTALLED USING "POLYLOK" FILTER

INITIAL SITE SKETCH Faith + Hope

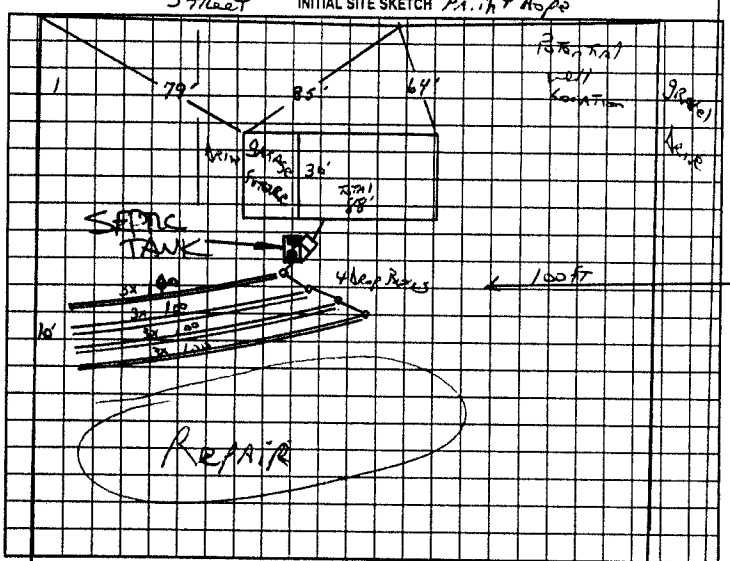

AS BUILT SKETCH

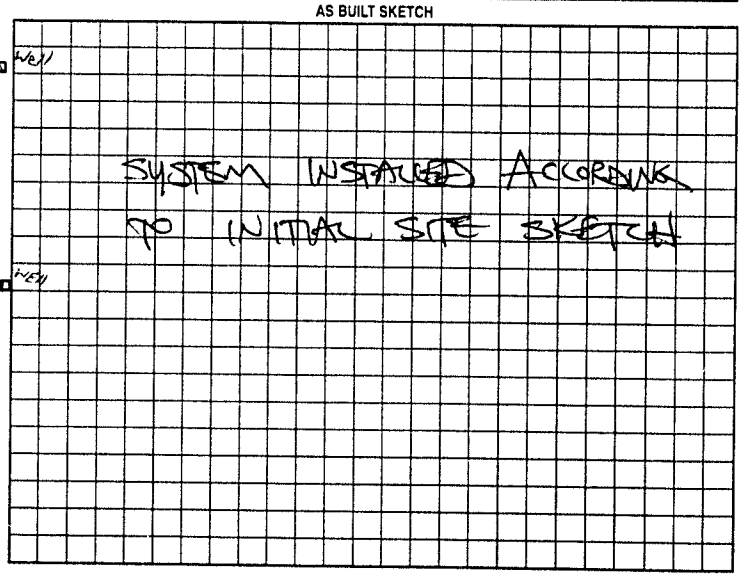

Permit can be suspended or revoked if any false information is supplied toward securing the permit/any unauthorized changes are made to the site/any unauthorized changes are made in the installation of the system. Improvement Permit with plat valid without expiration. Improvement Permit with site plan valid for sixty months. Authorization to Construct is valid for a period equal to that of Improvement Permit – not to exceed sixty months.

Signed: _____ date 6-16-2000 Installed by: LEVI NANTZ

Improvement Permit by: J. C. Potter date June 16 2000 Operation Permit by: STEVE HEDRICK date 8-18-00

Authorization to Construct by: J. C. Potter date June 16 2000 Existing System Inspection by: _____ date _____

HEALTH DEPT. COPY: WHITE OWNER COPY (FINAL): YELLOW OWNER COPY (INITIAL): PINK