IREDELL COUNTY HEALTH DEPARTMENT

STATESVILLE 704-878-5305 (1) MOORESVILLE 704-664-5281

IMPROVEMENT PERMIT / AUTHORIZATION TO CONSTRUCT / OPERATION PERMIT / EXISTING SYSTEM INSPECTION

(1)

PERMIT# 115548 PIN# 4752-52-9059 DATE 9-19-03

OWNER OR CONTRACTOR OAKWOOD MOBILE HOMES of TROUTMAN PHONE: Business 704-528-9449 Home 704-528-4516

ADDRESS 1042 CHARLOTTE HIGHWAY, TROUTMAN, NC 28116

LOCATION US 70 EAST, TR SHILOH ROAD, TR FAITH & HOPE LANE, 4TH LOT ON RIGHT

SUBDIVISION RAY CURRENT BLOCK / SECTION _____ LOT 2 LOT AREA 0.58 ACRE SITE CLASS. PS DESIGN FLOW 360 L.T.A.R. 0.40 GPD/FT²

Septic Tank: 1000 Gallons; STB 1012 Date 10-20-03
Pump Tank: _____ Gallons; PT _____ Date _____
Pump Make: _____ Model _____ Serial No. _____
Nitrification Field: No Fields 1 Square Feet 900 Linear Feet 300
No Lines FOUR Trench Width 36" Max Trench Bottom Depth 36" Gravel Depth 12"

☑ New System ☐ Repair System Type: I, (II), III, IV, V, VI
System Description: CONVENTIONAL GRAVITY
Repair System Description: 50% REDUCTION, GRAVITY
Maintenance Agreement Required: ☐ Yes ☑ No


☑ House/Mod. Home No. Bedrooms 3
~~☐ Mobile Home~~ No. Bathrooms 2
☐ Business No. Employees ____
☐ Other _____
☐ Slab ☑ Crawl Space ☐ Basement w/plumbing ☐ Basement wo/plumbing

Water Supply: ☑ Individual ☐ Public ☐ Community WELL

Comments:/Conditions: (1) KEEP SYSTEM MINIMUM 100 FEET FROM WELL (2) INSTALL LINES ON CONTOUR AS FLAGGED

Comments:/Conditions: SEPTIC TANK WITH MARKER INSTALLED USING "TUFFITE" FILTER

INITIAL SITE SKETCH

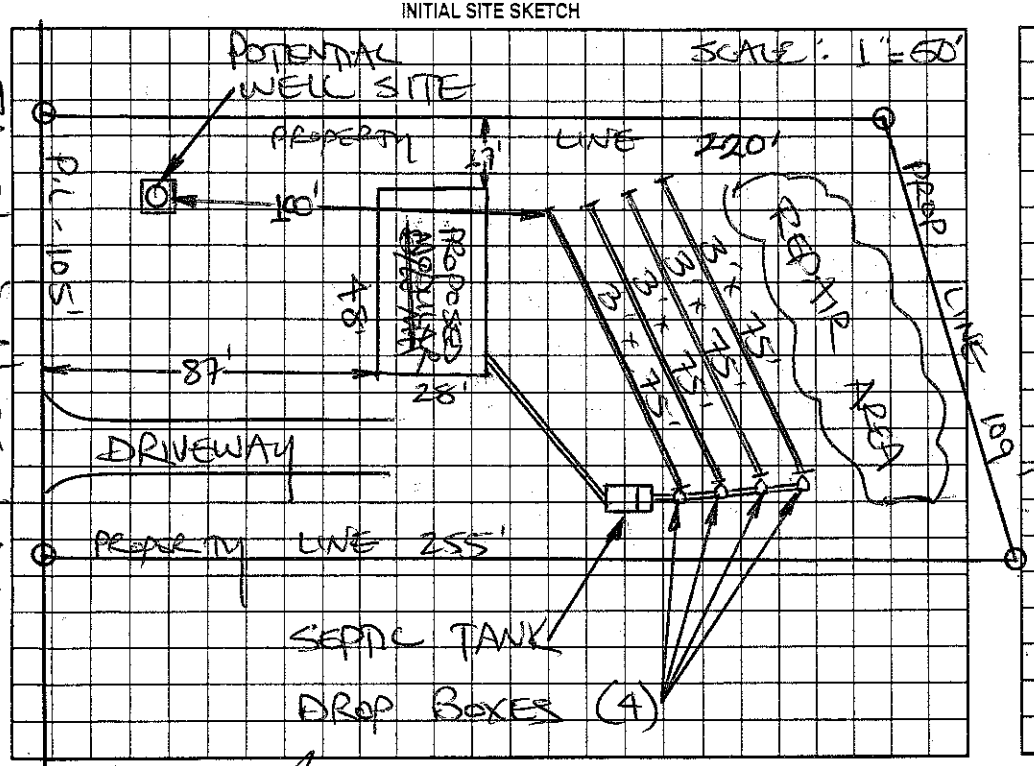

AS BUILT SKETCH

SYSTEM INSTALLED ACCORDING TO INITIAL SITE SKETCH

Permit can be suspended or revoked if any false information is supplied toward securing the permit/any unauthorized changes are made to the site/any unauthorized changes are made in the installation of the system. Improvement Permit with plat valid without expiration. Improvement Permit with site plan valid for sixty months. Authorization to Construct is valid for a period equal to that of Improvement Permit – not to exceed sixty months.

Signed: _____ date 9-19-03 Installed by: C & S GRADING

Improvement Permit by: STEVE HEDRICK date 9-19-03 Operation Permit by: STEVE HEDRICK date 4-30-04

Authorization to Construct by: STEVE HEDRICK date 9-19-03 Existing System Inspection by: _____ date _____

HEALTH DEPT. COPY: WHITE OWNER COPY (FINAL): YELLOW OWNER COPY (INITIAL): PINK