Paid 175.00 CK

IREDELL COUNTY HEALTH DEPARTMENT

STATESVILLE 704-878-5305 MOORESVILLE 704-664-5281

IMPROVEMENT PERMIT / AUTHORIZATION TO CONSTRUCT / OPERATION PERMIT / EXISTING SYSTEM INSPECTION

PERMIT# 09197 PIN# 4752 52 9396

OWNER OR CONTRACTOR David W. Brown PHONE: Business 663-7573 Home DATE August 22, 00

ADDRESS 195 Shinnville Rd Mooresville

LOCATION 70 EAST TR Shiloh Rd. on Right past Shiloh Methodist Church

SUBDIVISION BLOCK / SECTION LOT LOT AREA 2 / Ac± SITE CLASS PS DESIGN FLOW 600gpd L.T.A.R. .3

Septic Tank: 1500 * Gallons; STB 10 11 Date 4-16-00

Pump Tank: 1500 * Gallons; PT 99 Date 12-13-98

Pump Make: Hydromatic Model Sheps 04 Serial No. 5186704

Nitrification Field: No Fields 1 Square Feet 1500 Linear Feet 500

No Lines 4 Trench Width 36" Max Trench Bottom Depth 36" Gravel Depth NA

☑ New System ☐ Repair System Type: I II III IV V

System Description: PM - Innovative 25% Reduction

Repair System Description: PM/LP - Innovative/Approved

Maintenance Agreement Required: ☐ Yes ☑ No

☑ House/Mod. Home No. Bedrooms 5

☐ Mobile Home No. Bathrooms 3

☐ Business No. Employees

☐ Other

☐ Slab ☐ Crawl Space ☑ Basement w/plumbing ☐ Basement wo/plumbing

Water Supply: ☑ Individual ☐ Public ☐ Community

Comments/Conditions:


Follow contour with laterals As Plotted.

* 1250 gal minimum Allowed by Rule .1952


Comments/Conditions Lines OK - GM 12/9/00

Poly-Lok Filter Pressure Sat - 1/12/01 GM

INITIAL SITE SKETCH

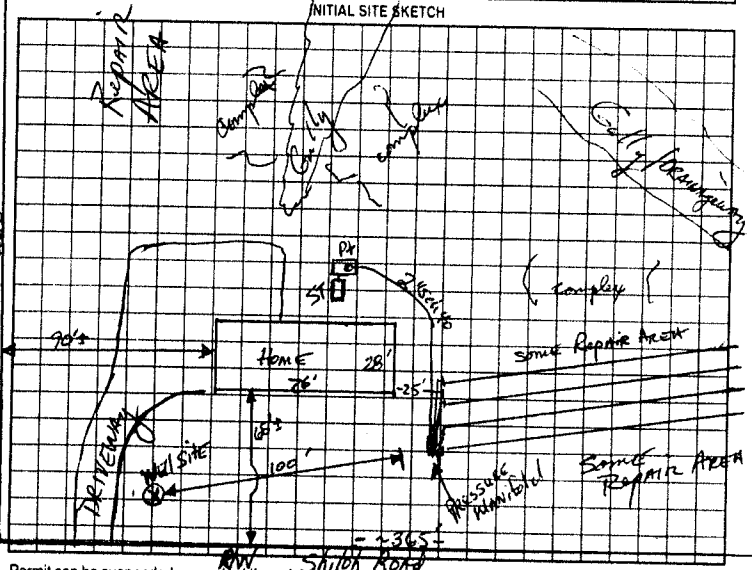

AS BUILT SKETCH

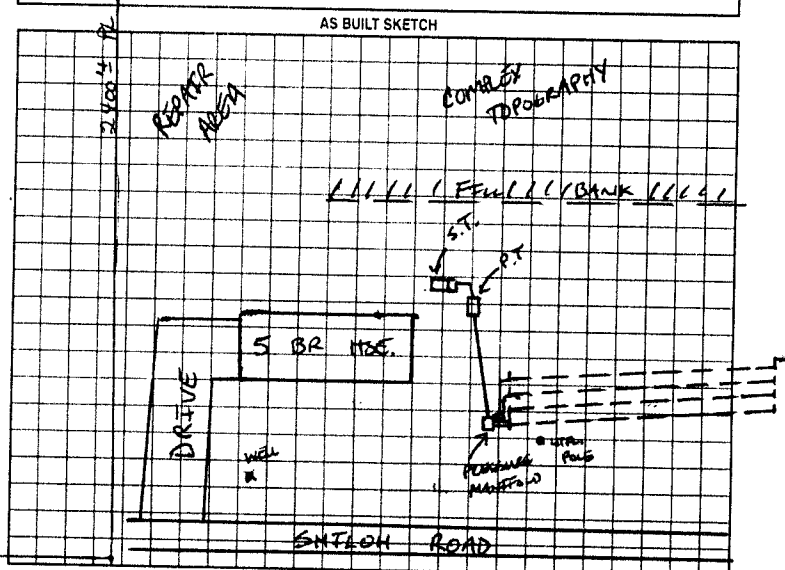

Permit can be suspended or revoked if any false information is supplied toward securing the permit/any unauthorized changes are made to the site/any unauthorized changes are made in the installation of the system. Improvement Permit with plat valid without expiration. Improvement Permit with site plan valid for sixty months. Authorization to Construct is valid for a period equal to that of Improvement Permit – not to exceed sixty months.

Signed: David W. Brown

Improvement Permit by: [signature] date 8-23-00

Authorization to Construct by: [signature] date 8-22-00

Installed by: A-1 BACKHOE

Operation Permit by: STEVE HEDRICK date 3-22-01

Existing System Inspection by: date

HEALTH DEPT. COPY WHITE OWNER COPY (FINAL) YELLOW OWNER COPY (INITIAL) PINK