IREDELL COUNTY HEALTH DEPARTMENT

Statesville Office (704) 878-5305 Mooresville Office (704) 660-3625 PERMIT # 216913

IMPROVEMENT PERMIT / AUTHORIZATION TO CONSTRUCT / OPERATION PERMIT / EXISTING SYSTEM PIN # 4752615873

APPLICANT: Chamhouane Patsakham APPLICANT ADDRESS: 840 Shiloh Rd Statesville NC 28677

SITE ADDRESS: 840 Shiloh Rd Statesville NC 28677 PHONE: 386-315-2466 ALT. PHONE: N/A

SITE DIRECTIONS: 70 E T/R Shiloh Rd Lot on right beside Faith + Hope Rd

SUBDIVISION: John L Madison Sr SECTION: N/A LOT# N/A LOT AREA: 2.04 ac DESIGN FLOW: 240 L.T.A.R.: Ex

Septic Tank Ex (gal) STB Date

Pump Tank (gal) PT Date

Pump Make Model Serial #

Nitrification Fields Ex # Lines Ex Linear Ft: Ex

Trench Width Ex Max. Trench Bottom Depth Ex Gravel Depth Ex

☐ New System ☐ Repair ☐ Expansion System Type: I II [III] IV V VI

System Description: Existing

Repair System Description:

Maintenance Agreement Required: ☐ YES ☒ NO

☒ GRAVITY ☐ PRESSURE

☒ Residence No. Bedrooms 2

☐ Business No. Persons 4

☐ Other No. Employees

☐ Slab ☒ Crawl Space

☐ Basement w/plumbing ☐ Basement w/o plumbing

Water Supply

☐ Private


☐ Public

☒ Community


Comments / Conditions: Maintain 5' off any part of STS.

Setbacks approved per zoning if house is replaced within 6 month of being removed.

INITIAL SITE SKETCH

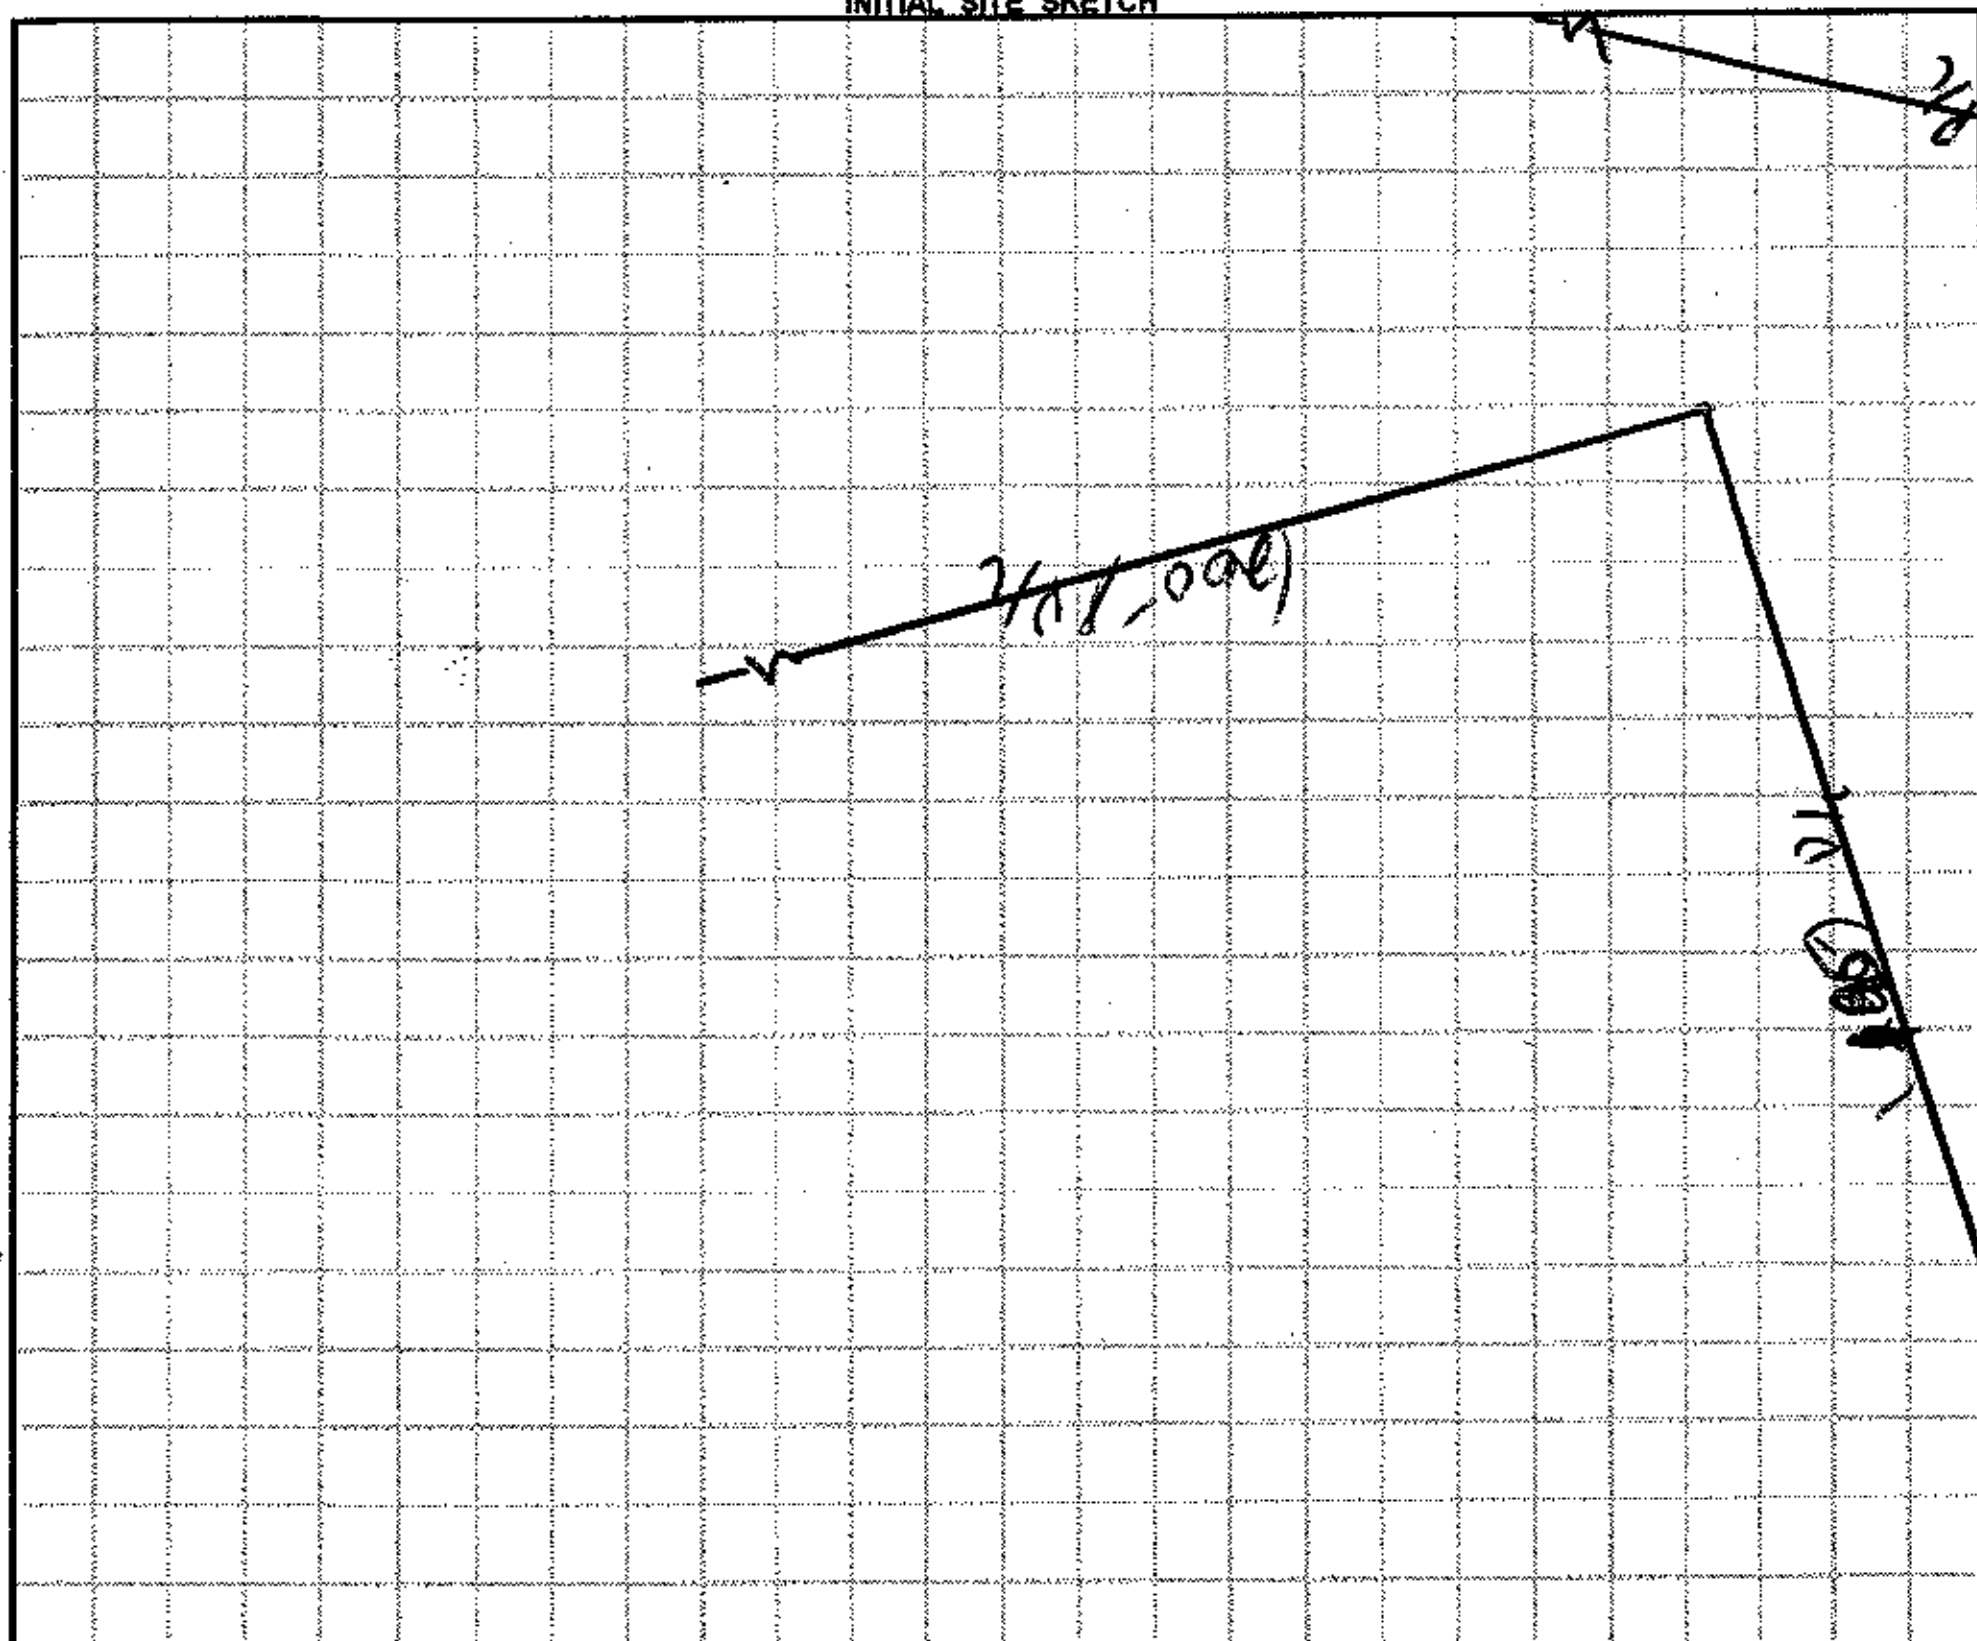

AS BUILT SKETCH

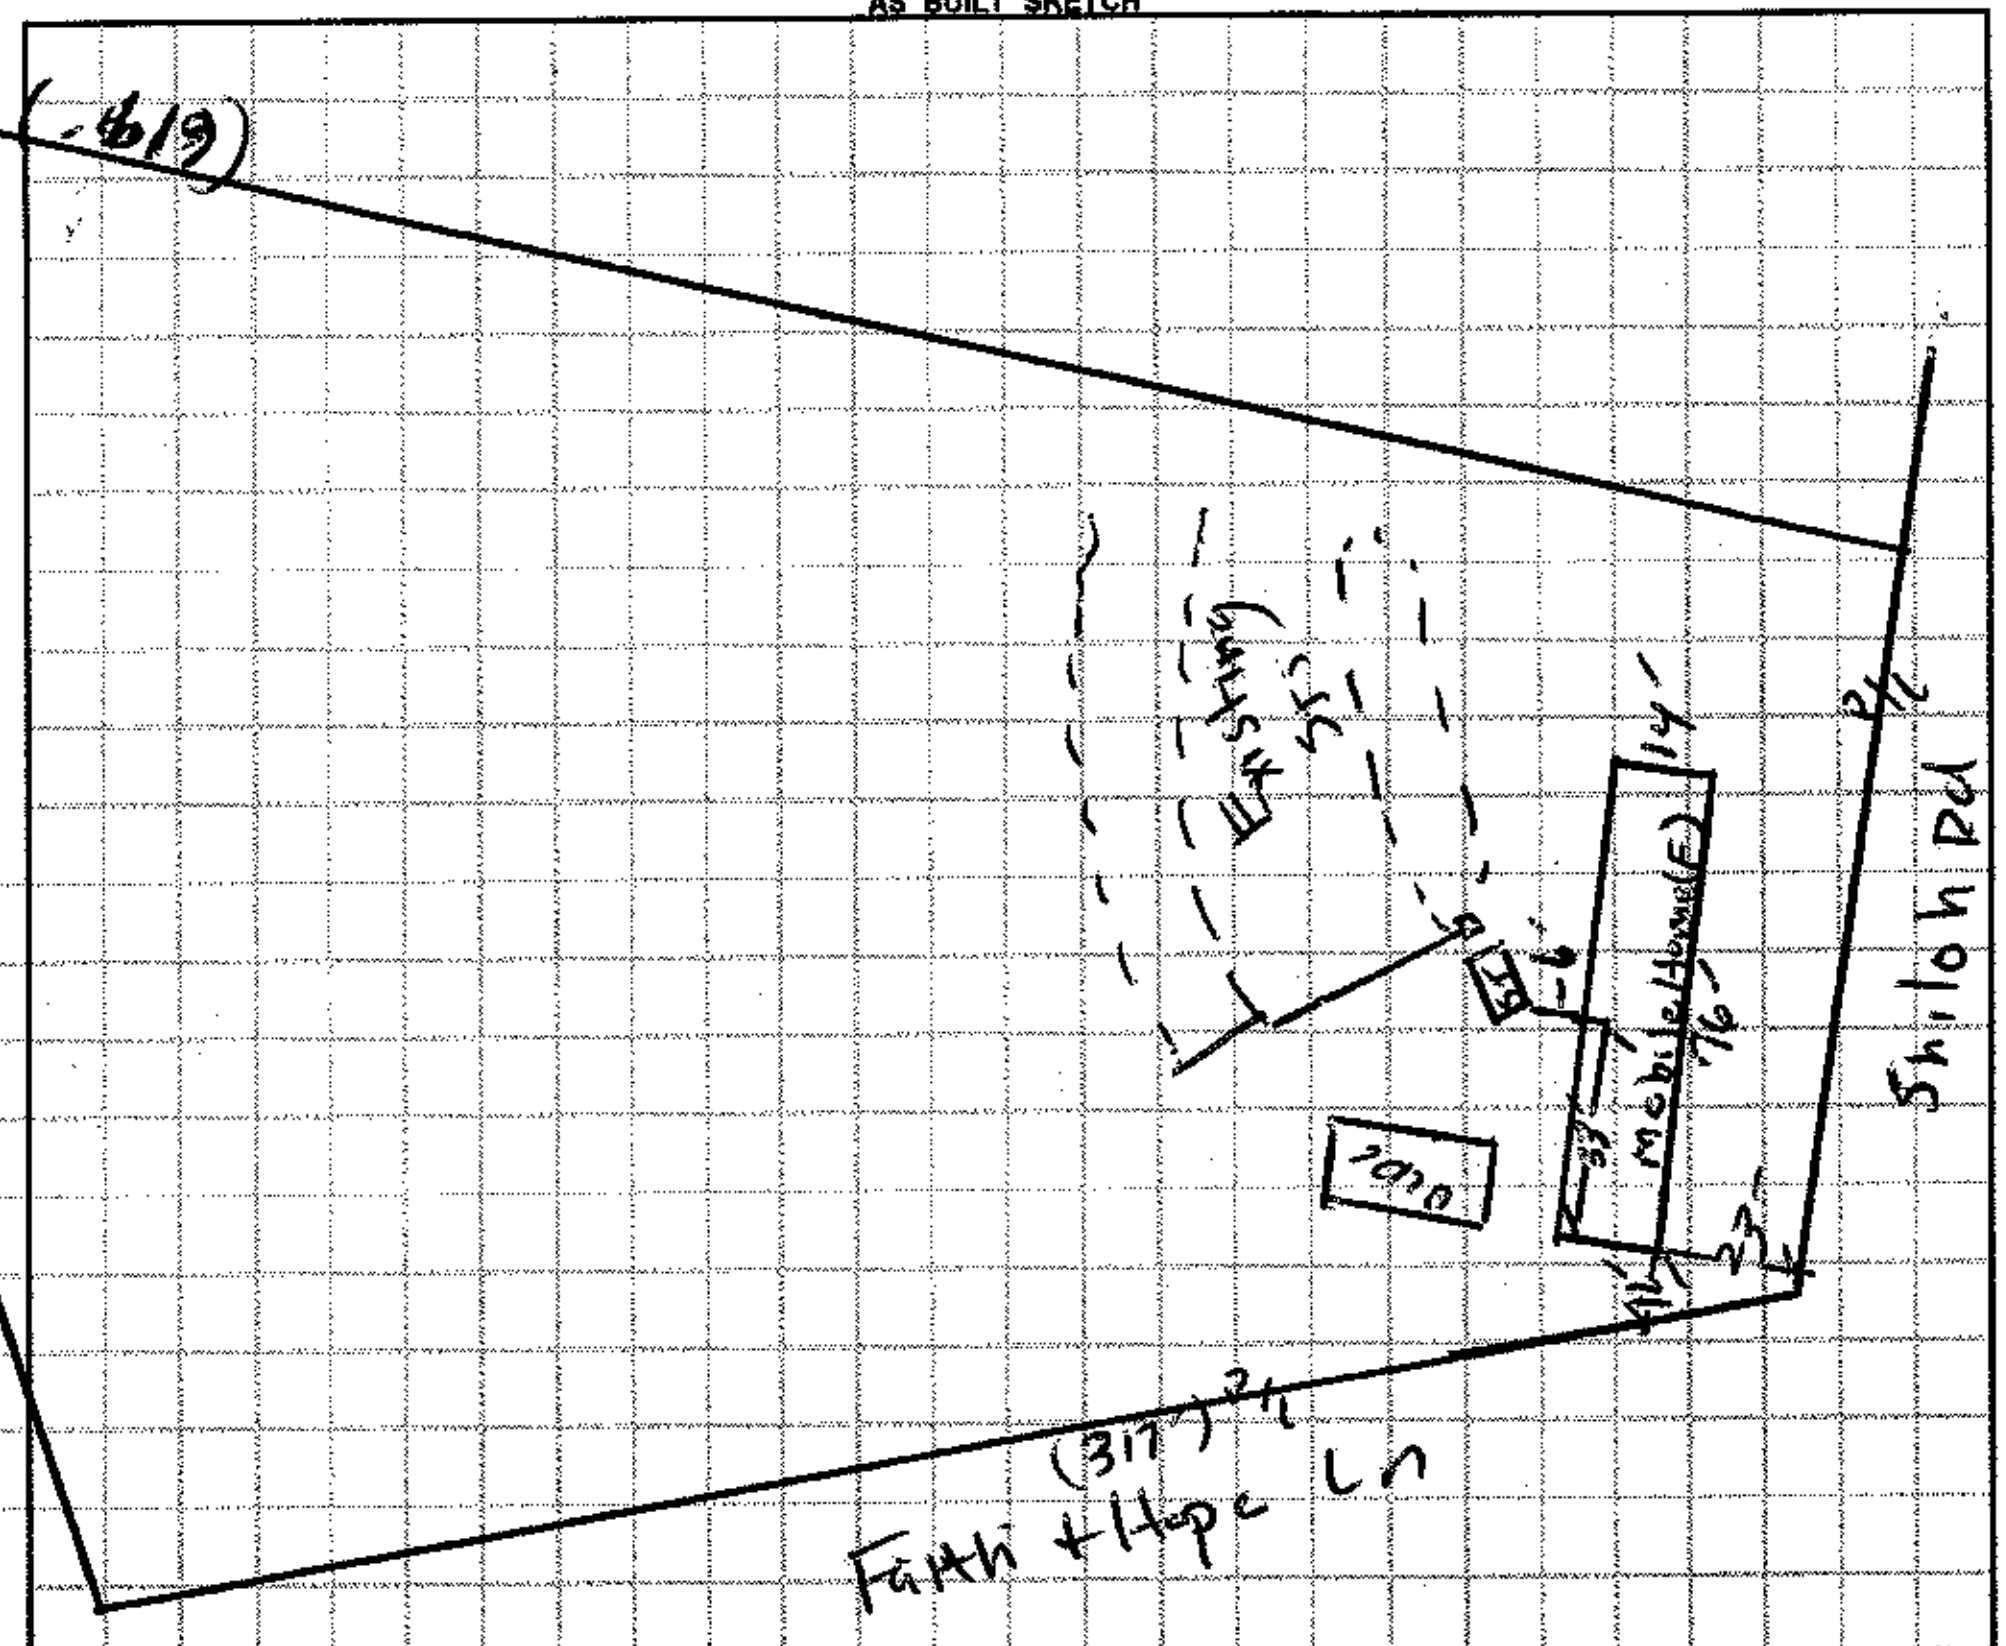

Permit can be suspended or revoked if any false information is supplied toward securing the permit / any unauthorized changes are made to the site / any unauthorized changes are made in the installation of the system. **CONTACT A LOCATOR SERVICE PRIOR TO ANY EXCAVATION**

☐ **IMPROVEMENT PERMIT with plat** *valid without expiration.* ☐ **IMPROVEMENT PERMIT with site plan** *valid for 60 mos.* ☐ **AUTHORIZATION TO CONSTRUCT** *valid for period equal to IMPROVEMENT PERMIT--not to exceed 60 mo.*

Owner / Applicant Signature: Chamhoua patsakham Date: 3-29-2016 Installed by:

IMPROVEMENT PERMIT by: Date: OPERATION PERMIT by: Date:

AUTHORIZATION TO CONSTRUCT by: Date: Existing System Inspected by: [signature] Date: 03/28/16

Health Dept. Copy - WHITE Applicant (Final Approval) - YELLOW Applicant (Conditional Approval) - PINK