IREDELL COUNTY HEALTH DEPARTMENT

STATESVILLE 704-878-5305 MOORESVILLE 704-664-5281

IMPROVEMENT PERMIT / AUTHORIZATION TO CONSTRUCT / OPERATION PERMIT / EXISTING SYSTEM INSPECTION

PERMIT# 87016 PIN# 4752618930 DATE 1-07-00

OWNER OR CONTRACTOR Andrew Johnson PHONE: Business _____ Home 871-2121

ADDRESS 834 Shiloh Rd Statesville, N.C.

LOCATION 70E 712 Shiloh Rd TR 2.5 miles on Rt

SUBDIVISION _____ BLOCK / SECTION _____ LOT _____ LOT AREA .50 acres SITE CLASS PS DESIGN FLOW 480 L.T.A.R. .4

Septic Tank: 1000 Gallons; STB 786 Date 12-3-99
Pump Tank: _____ Gallons; PT _____ Date _____
Pump Make: _____ Model _____ Serial No. _____
Nitrification Field: No Fields 1 Square Feet 1200 Linear Feet 400
No Lines 5 Trench Width 36" Max Trench Bottom Depth 36" Gravel Depth 12"

☒ New System ☐ Repair System Type: I (II) III, IV, V, VI
System Description: Conv. Gravity
Repair System Description: Pump to ~~Gravity~~ 25% Red.
Maintenance Agreement Required: ☐ Yes ☒ No


☐ House/Mod. Home No. Bedrooms 4
☒ Mobile Home No. Bathrooms 2
☐ Business No. Employees _____
☐ Other _____
☐ Slab ☐ Crawl Space ☐ Basement w/plumbing ☐ Basement wo/plumbing

Water Supply: ☐ Individual ☐ Public ☒ Community


Comments/Conditions:

Comments/Conditions

INITIAL SITE SKETCH 183

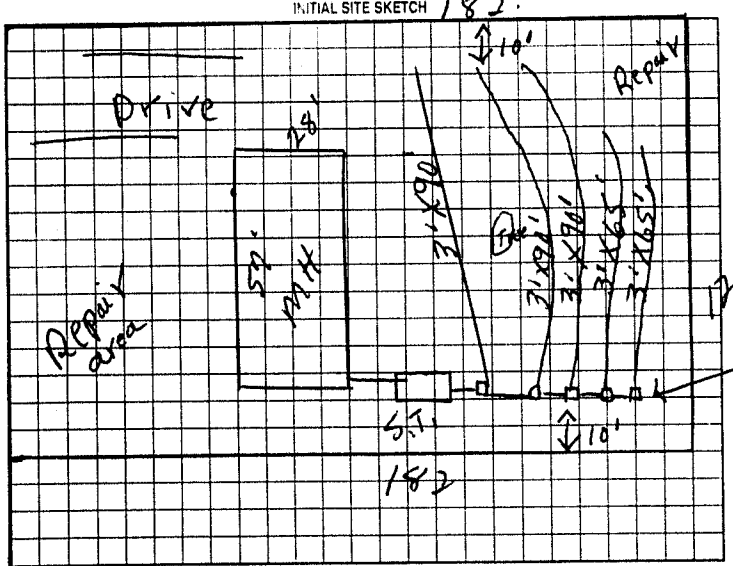

AS BUILT SKETCH

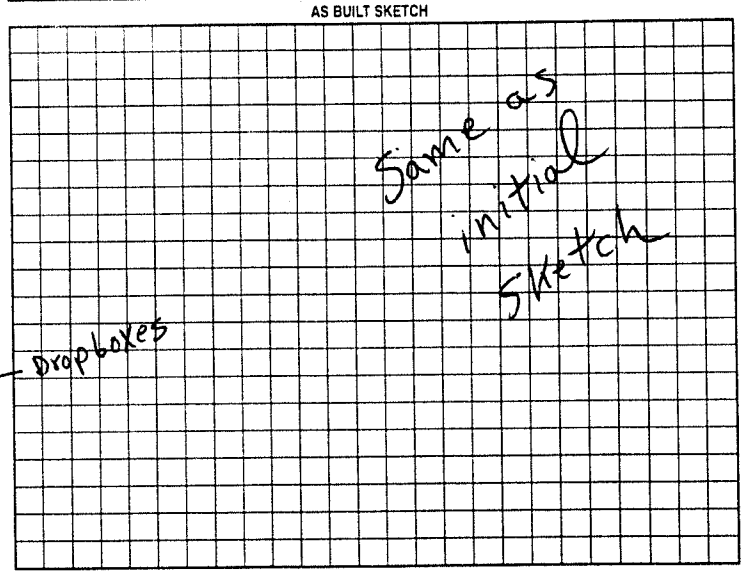

Street 120'

Permit can be suspended or revoked if any false information is supplied toward securing the permit/any unauthorized changes are made to the site/any unauthorized changes are made in the installation of the system. Improvement Permit with plat valid without expiration. Improvement Permit with site plan valid for sixty months. Authorization to Construct is valid for a period equal to that of Improvement Permit – not to exceed sixty months.

Signed: X. Paul Melch date _____ Installed by: G & M Enterprises

Improvement Permit by: P. C. Moore date 1-07-00 Operation Permit by: P. C. Moore date 2-25-00

Authorization to Construct by: P. C. Moore date 1-07-00 Existing System Inspection by: _____ date _____

HEALTH DEPT. COPY: WHITE OWNER COPY (FINAL): YELLOW OWNER COPY (INITIAL): PINK