IREDELL COUNTY HEALTH DEPARTMENT

STATESVILLE 704-878-5305 MOORESVILLE 704-664-5281 (C1)

IMPROVEMENT PERMIT / AUTHORIZATION TO CONSTRUCT / OPERATION PERMIT / EXISTING SYSTEM INSPECTION

PERMIT# 122642 PIN# 4752-62-1005 DATE 8-9-09

OWNER OR CONTRACTOR PACHANA BOUROMMAVONG PHONE: Business 704-450-9925 Home

ADDRESS 150 FAITH & HOPE ROAD, STATESVILLE, NC 28677

LOCATION US 70 EAST, TR SHILOH ROAD, TR FAITH & HOPE LANE, LOT ON RIGHT AT #132

SUBDIVISION BLOCK / SECTION LOT 3 LOT AREA 1.37 ACRES SITE CLASS. PS DESIGN FLOW 240 L.T.A.R. EXISTING 0.33 GPD/FT2

Septic Tank: 1000 Gallons; STB Date

Pump Tank: Gallons; PT Date

Pump Make: Model Serial No.

Nitrification Field: No Fields 1 Square Feet 720 Linear Feet 240

No Lines THREE Trench Width 36" Max Trench Bottom Depth 36" Gravel Depth 12"

☐ New System ☐ Repair System Type: I (II) III, IV, V, VI

System Description: CONVENTIONAL, GRAVITY

Repair System Description:

Maintenance Agreement Required: ☐ Yes ☒ ~~No~~

☐ House/Mod. Home ☒ ~~Mobile Home~~ ☐ Business ☐ Other

No. Bedrooms 2 No. Bathrooms 2 No. Employees


☐ Slab ☒ Crawl Space ☐ Basement w/plumbing ☐ Basement wo/plumbing

Water Supply: ☒ ~~Individual~~ ☐ Public ☐ Community WELL, MUST DRILL


Comments:/Conditions:

Comments:/Conditions: (2) SYSTEM SIZED FOR TWO BEDROOMS ONLY (2) EXISTING S/W MH TO BE REMOVED

INITIAL SITE SKETCH

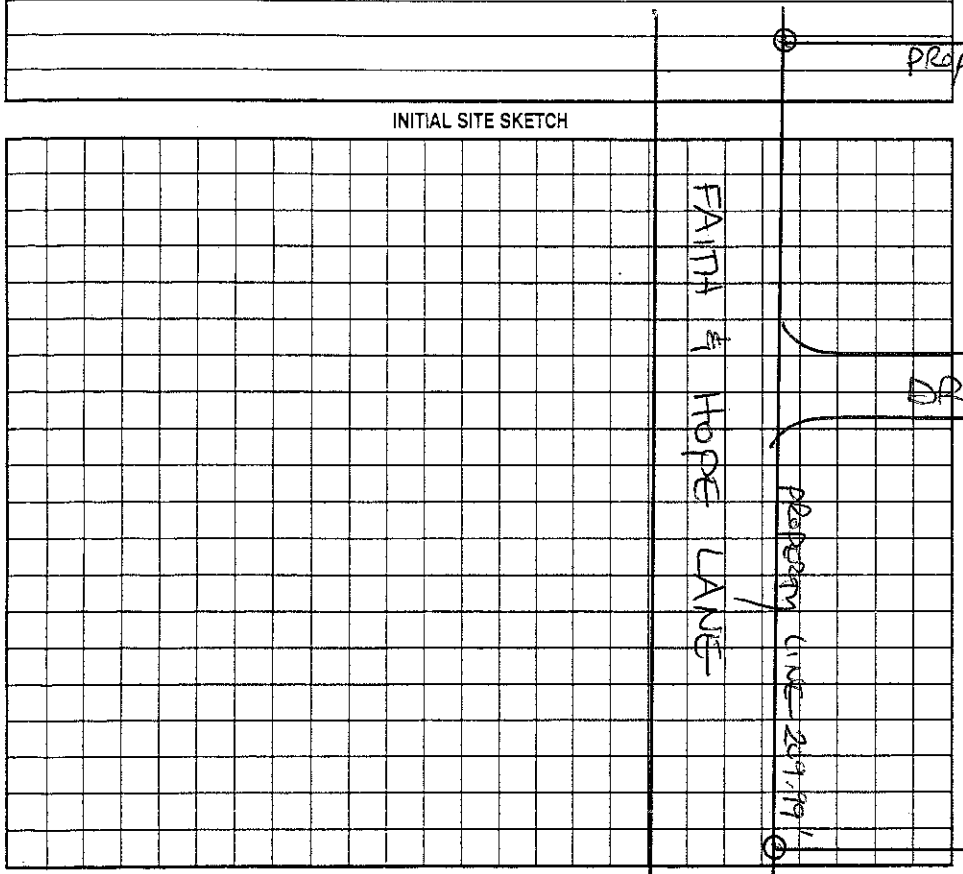

AS BUILT SKETCH

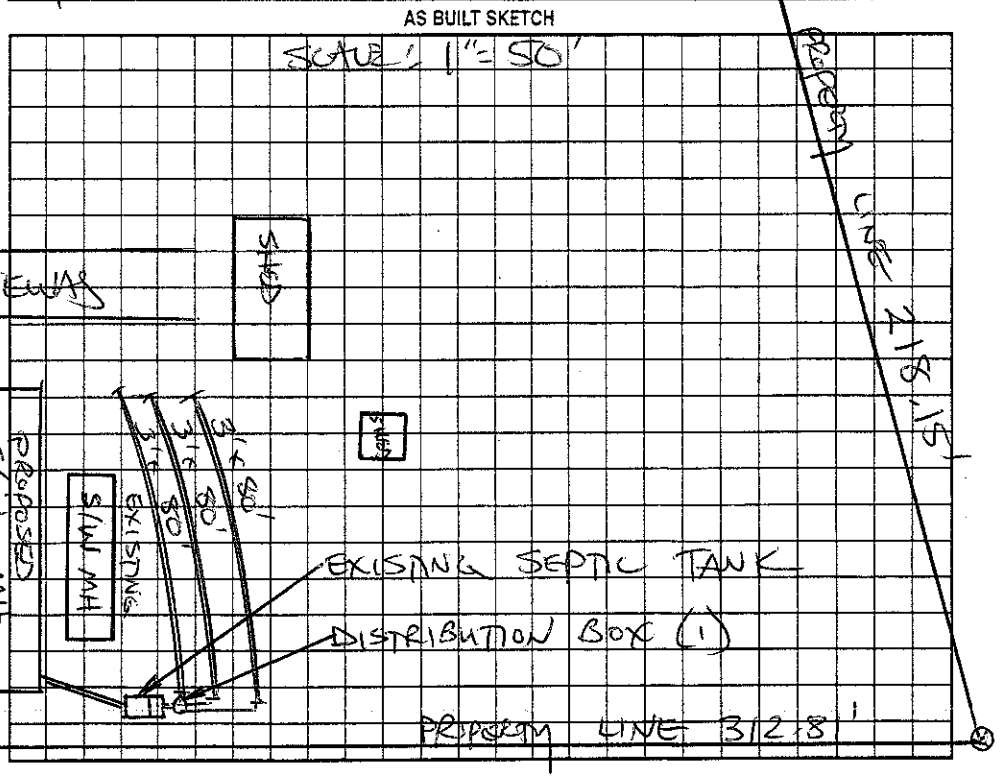

Permit can be suspended or revoked if any false information is supplied toward securing the permit/any unauthorized changes are made to the site/any unauthorized changes are made in the installation of the system. Improvement Permit with plat valid without expiration. Improvement Permit with site plan valid for sixty months. Authorization to Construct is valid for a period equal to that of Improvement Permit – not to exceed sixty months.

Signed: date Installed by:

Improvement Permit by: date Operation Permit by: date

Authorization to Construct by: date Existing System Inspection by: STEVE HEDRICK date 8-9-09

HEALTH DEPT. COPY: WHITE OWNER COPY (FINAL): YELLOW OWNER COPY (INITIAL): PINK