3:00 # 63861

IREDELL COUNTY HEALTH DEPARTMENT

STATESVILLE 704-878-5305 MOORESVILLE 704-664-5281

IMPROVEMENT PERMIT / CERTIFICATE OF COMPLETION / OPERATION PERMIT / EXISTING SYSTEM INSPECTION

PROPERTY DESCRIPTION NO. 25391 DATE 10-29-96 TAX MAP NO. 5D-A-14 Watershed: ☐ Yes ☐ No

OWNER OR CONTRACTOR James P. Cook PHONE: Business _____ Home 873-9418

ADDRESS 128 Pixler Fm Rd

LOCATION NOE TR Shiloh Church Sta TR Pixler Fm at end

SUBDIVISION EV BLOCK / SECTION _____ LOT _____ LOT AREA 4 acres SITE CLASS. PS DESIGN FLOW 360 L.T.A.R. 135

Septic Tank: 1000 Gallons; STB _____ Date _____

Pump Tank: _____ Gallons; PT _____ Date _____

Pump Make: _____ Model _____ Serial No. _____

Nitrification Field: No Fields 1 Square Feet 450 Linear Feet 150

No Lines 1 Trench Width 36" Max Trench Bottom Depth 36" Gravel Depth 12"

☐ New System ☐ Repair System Type: I, II, III, IV, V, VI

System Description: _____

Repair System Description: conv. trench

Maintenance Agreement Required: ☐ Yes ☐ No

☐ House/Mod. Home No. Bedrooms 3

☐ Mobile Home No. Bathrooms 2

☐ Business No. Employees _____

☐ Other _____


☐ Slab ☐ Crawl Space ☐ Basement w/plumbing ☐ Basement w/o/plumbing

Water Supply: ☐ Individual ☐ Community ☐ Public


Comments: Changing To 3 " 1 2 bedroom Home

Comments:

INITIAL SITE SKETCH

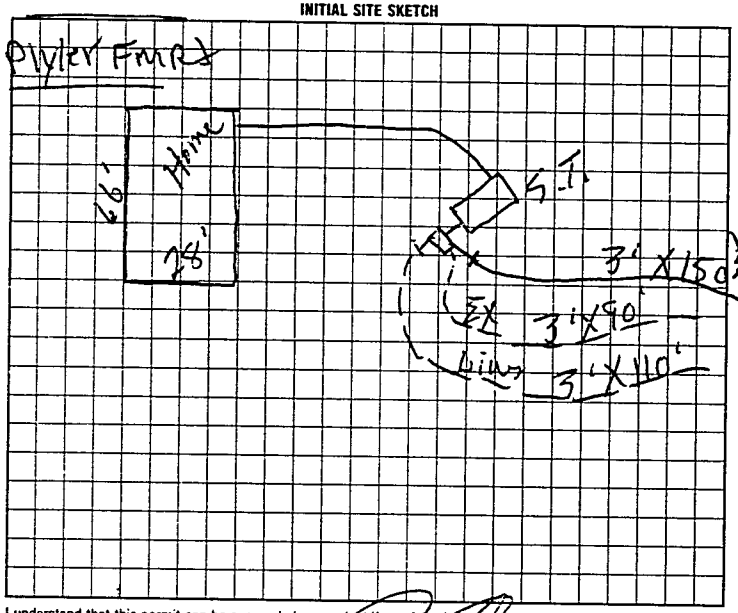

AS BUILT SKETCH

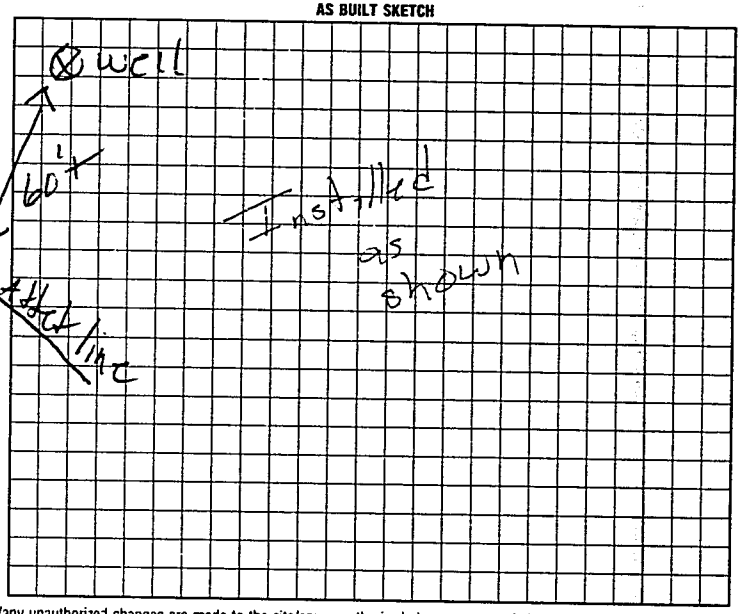

I understand that this permit can be suspended or revoked if any false information is supplied toward securing the permit/any unauthorized changes are made to the site/any unauthorized changes are made in the installation of the system.

Signed: X James P. Cook

Improvement Permit by: E.C. Moore date 10-29-96

Existing System Inspection by: E.C. Moore date 10-29-96

Installed by: A-1 Backhoe

Certificate of Completion by: _____ date _____

Operation Permit by: Mary C. Ott RS date 1-8-97

to county authorization to count. Expires 60 mos from issue

HEALTH DEPT. COPY: WHITE INSPECTION COPY (FINAL): GREEN OWNER COPY (FINAL): YELLOW INSPECTION COPY (INITIAL): PINK OWNER COPY (INITIAL): BLUE

2002