3.00 # 63861

IREDELL COUNTY HEALTH DEPARTMENT

STATESVILLE 704-878-5305 MOORESVILLE 704-664-5281

IMPROVEMENT PERMIT / CERTIFICATE OF COMPLETION / OPERATION PERMIT / EXISTING SYSTEM INSPECTION

PROPERTY DESCRIPTION NO. 25391 DATE 10-29-96 TAX MAP NO. 5D-17-17 Watershed: ☐ Yes ☒ No

OWNER OR CONTRACTOR James P. Cook PHONE: Business Home 873-9418

ADDRESS

LOCATION 125 Pyler Farm Rd to Shiloh Church Rd to Pyler Farm at end

SUBDIVISION BLOCK / SECTION LOT LOT AREA 4 acres SITE CLASS. PS: DESIGN FLOW 360 L.T.A.R. 1.35

Septic Tank: 1000 Gallons; STB Date

Pump Tank: Gallons; PT Date

Pump Make: Model Serial No.

Certification Field: No Fields 1 Square Feet 450 Linear Feet 150

No Lines 1 Trench Width 36" Max Trench Bottom Depth 36" Gravel Depth 12"

☐ New System ☐ Repair System Type: I II III IV V VI

System Description:

Repair System Description: Conv. Gravity

Maintenance Agreement Required: ☐ Yes ☒ No

☒ House/Mod. Home No. Bedrooms 3

☐ Mobile Home No. Bathrooms 2

☐ Business No. Employees

☐ Other


☐ Slab ☒ Crawl Space ☐ Basement w/p. ☐ Basement wo/plumbing

Water Supply: ☒ Individual ☐ Community ☐ Public


Comments: Changing 2 bedroom Home To 3 " "

Comments:

INITIAL SITE SKETCH

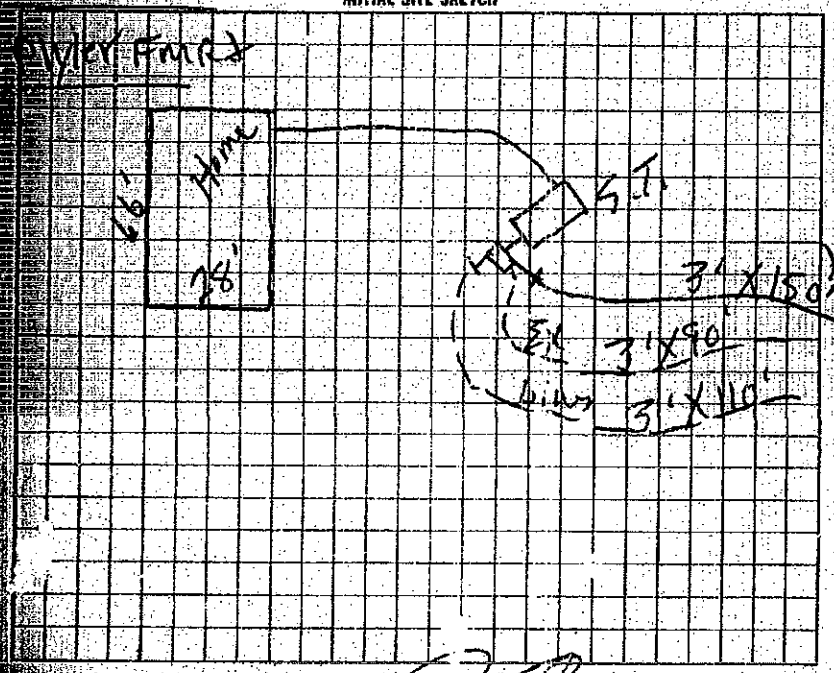

AS BUILT SKETCH

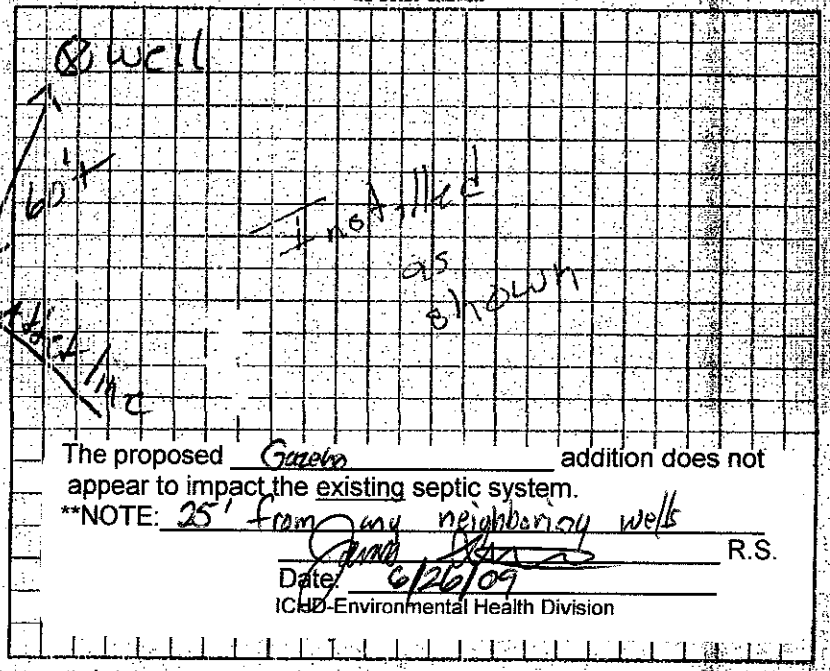

The proposed Gazebo addition does not appear to impact the existing septic system.

**NOTE: 25' from any neighboring wells

R.S.

Date 6/26/09

ICHD-Environmental Health Division

I understand that this permit can be suspended or revoked if any false information is supplied toward securing the permit/any unauthorized changes are made to the site/any unauthorized changes are made in the installation of the system.

Signed: X

Installed by: A-1 Backhoe

24' Pool

40X18 pole w/ 8' concrete border

gazebo