3.00 # 63861

IREDELL COUNTY HEALTH DEPARTMENT

STATESVILLE 704-878-5305 MOORESVILLE 704-664-5281

IMPROVEMENT PERMIT / CERTIFICATE OF COMPLETION / OPERATION PERMIT / EXISTING SYSTEM INSPECTION

PROPERTY DESCRIPTION NO. 25391 DATE 10-29-96 TAX MAP NO. 5D-17-17 Watershed: ☐ Yes ☐ No

OWNER OR CONTRACTOR James P. Cook PHONE: Business Home 873-9418

ADDRESS

LOCATION 128 Pyler Rd Statesville Enter Pyler Rd at end

SUBDIVISION BLOCK / SECTION LOT LOT AREA 1 acre SITE CLASS. PS DESIGN FLOW 360 L.T.A.R. 135

Septic Tank: 1000 Gallons; STB Date

Pump Tank: Gallons; PT Date

Pump Make: Model Serial No.

Application Field: No Fields 1 Square Feet 450 Linear Feet 150

No Lines 1 Trench Width 36" Max Trench Bottom Depth 36" Gravel Depth 12"

☐ New System ☐ Repair System Type: I, II, III, IV, V, VI

System Description:

Repair System Description: Conv. Gravity

Maintenance Agreement Required: ☐ Yes ☐ No

☐ Slab ☐ Crawl Space ☐ Basement w/p. ☐ Basement w/o plumbing

☐ House/Mod. Home ☐ Mobile Home ☐ Business ☐ Other


No. Bedrooms 3 No. Bathrooms 2 No. Employees

Water Supply: ☐ Individual ☐ Community ☐ Public


Comments: Changing To 3 Bedroom Home

Comments:

INITIAL SITE SKETCH

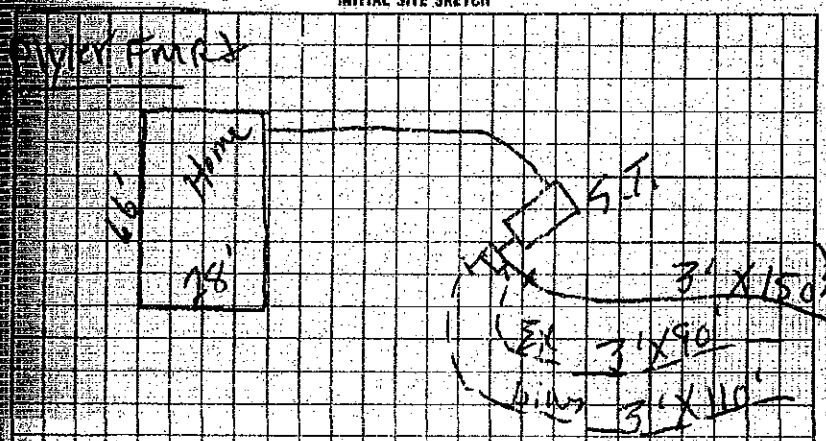

AS BUILT SKETCH

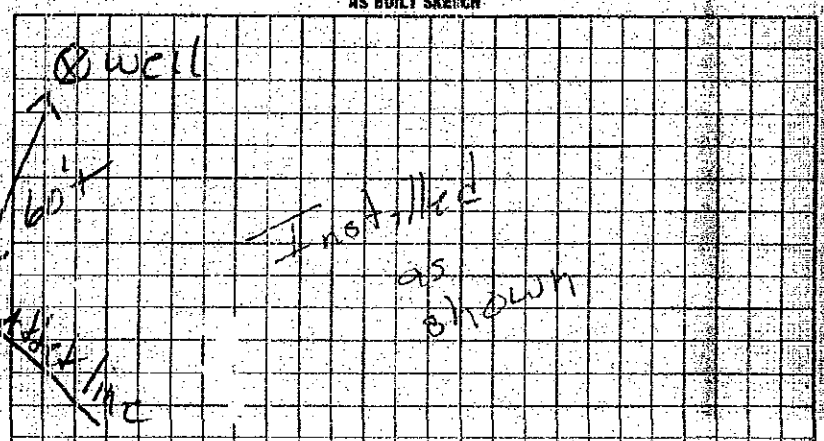

The proposed Swimming pool addition does not appear to impact the existing septic system.

**NOTE:

R.S.

Date: 5-26-09

ICHD Environmental Health Division

I understand that this permit can be suspended or revoked if any false information is supplied toward securing the permit/any unauthorized changes are made to the site/any unauthorized changes are made in the installation of the system.

Signed: Installed by: A-1 Backhoe

1 1000 gal tank

40x18 pool w/ 8' concrete border

FEB. 10, 1989 18:33