IREDELL COUNTY HEALTH DEPARTMENT

STATESVILLE 704-878-5305 MOORESVILLE 704-664-5281

IMPROVEMENT PERMIT / AUTHORIZATION TO CONSTRUCT / OPERATION PERMIT / EXISTING SYSTEM INSPECTION

PERMIT# 150821 PIN# 4752652005 DATE 6-11-08

OWNER OR APPLICANT Leonard Tyler PHONE: Business Home 704-871-9780

ADDRESS 1650 Shiloh Rd Statesville NC 28677

LOCATION 70 East to Shiloh Church Rd to R at Dot 1650

SUBDIVISION BLOCK / SECTION LOT LOT AREA 6.1 Ac SITE CLASS. P3 DESIGN FLOW 240 L.T.A.R. .3

Septic Tank: 1000 Gallons; STB 754 Date 5-24-08
Pump Tank: Gallons; PT Date
Pump Make: Model Serial No.
Nitrification Field: No Fields Square Feet 800 Linear Feet 200
No Lines 4 Trench Width 36 Max Trench Bottom Depth 24

☑ New System ☐ Repair ☐ Expansion System Type: I II III IV V VI
System Description: 25% Grade
Repair System Description: 25% Grade
Maintenance Agreement Required: ☐ Yes ☐ No
Gravel Depth ☐ Gravity ☐ Pressure

☐ House/Mod. Home ☑ Mobile Home ☐ Business ☐ Other
No. Bedrooms 2 No. Persons No. Employees


Water Supply: ☑ Individual ☐ Public ☐ Community

☐ Slab ☑ Crawl Space ☐ Basement w/plumbing ☐ Basement wo/plumbing


Comments:/Conditions:
Maintain water line 50' away from septic

Comments:/Conditions:
Divert water Away from Septic
Maintain all setbacks
Install on Contour

INITIAL SITE SKETCH

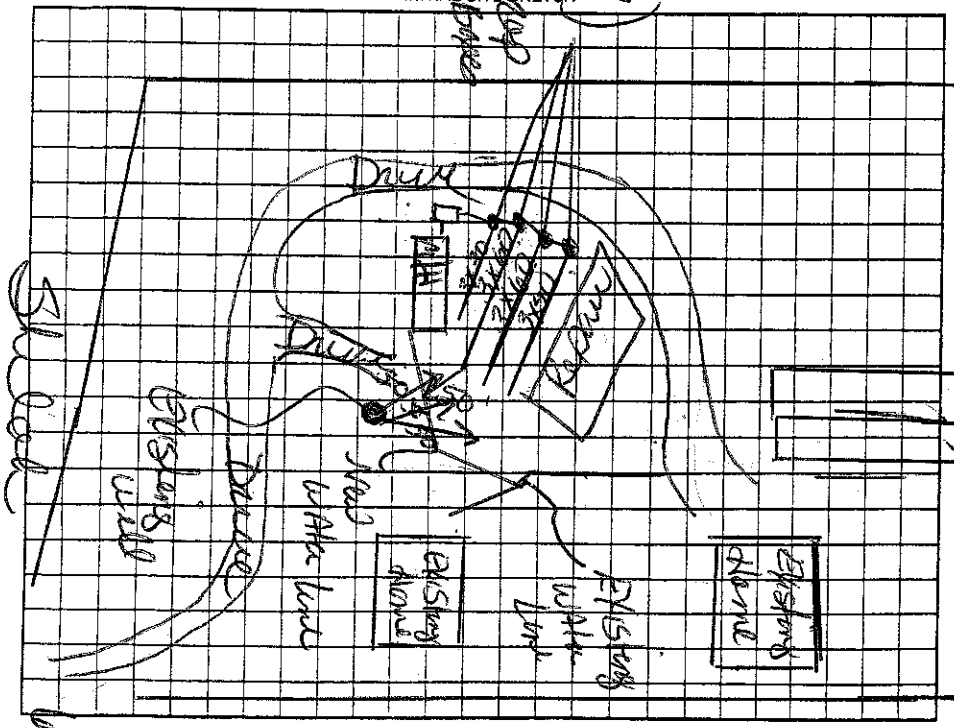

AS BUILT SKETCH

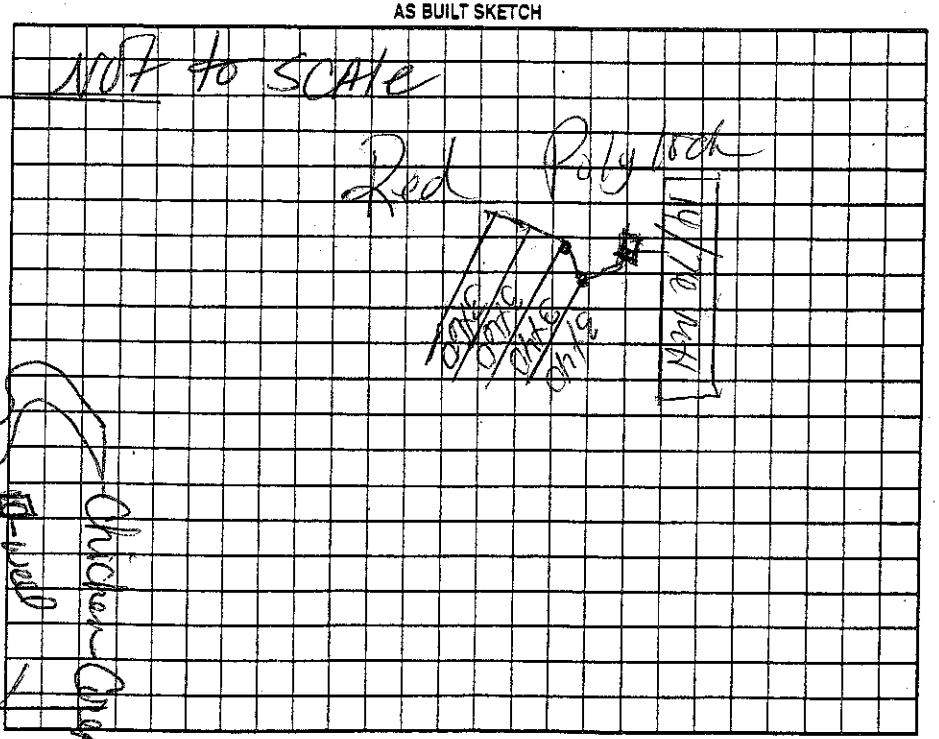

Permit can be suspended or revoked if any false information is supplied toward securing the permit/any unauthorized changes are made to the site/any unauthorized changes are made in the installation of the system. Improvement Permit with plat valid without expiration ☐ Improvement Permit with site plan valid for sixty months ☑ Authorization to Construct is valid for a period equal to that of Improvement Permit – not to exceed sixty months.

Signed: Leonard Tyler date

Improvement Permit by: Kelly Cook date 6-11-08

Authorization to Construct by: Kelly Cook date 6-11-08

Installed by: Marty Lytton

Operation Permit by: Kelly Cook date 7-28-08

Existing System Inspection by: date

HEALTH DEPT. COPY: WHITE OWNER COPY (FINAL): YELLOW OWNER COPY (INITIAL): PINK