IREDELL COUNTY HEALTH DEPARTMENT

Statesville Phone TR 3-7271 Mooresville Phone NO 3-1271

PERMIT TO INSTALL SEPTIC TANK

Permit NO. J A Mills Permit Date Feb 21 1966

Owner Edmiston & Mills Bldrs. Address R 1

Installed By C Hoke Address R 7

Location of Property Shiloh ch. Rd. off 70 E.


Cross Creek 2nd on R

Tank		Capacity		Length of Lines		Fixtures	
Block	( )	1000	( )	225'	( )	No. of Baths	(2)
Precast	(—)	1250	( )	250'	( )	Dishwasher	( )
		1500	( )	Other		Garbage Grdr.	( )
		Other				Other	

NOTIFY HEALTH DEPARTMENT AT LEAST EIGHT HOURS BEFORE TANK IS TO BE INSPECTED.

Final Inspection 19 Approved ( ) Disapproved ( )

Remarks well 50 '

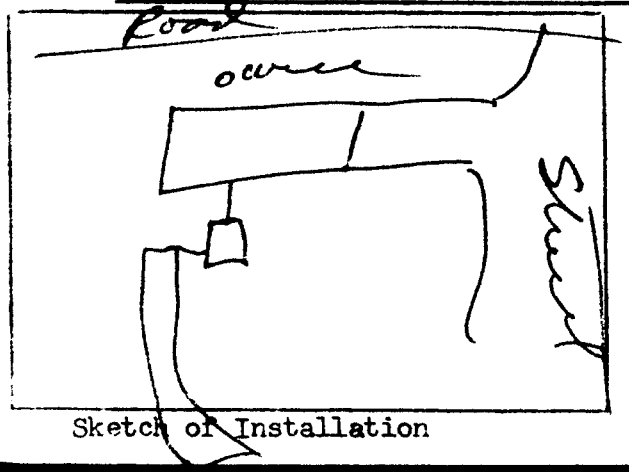

Sketch of Installation

Sanitarian