# IREDELL COUNTY HEALTH DEPARTMENT

STATESVILLE 704-878-5305 MOORESVILLE 704-664-5281

## IMPROVEMENT PERMIT / CERTIFICATE OF COMPLETION / OPERATION PERMIT / EXISTING SYSTEM INSPECTION

PROPERTY DESCRIPTION NO. 18286 DATE 4-18-94 TAX MAP NO. 5K-A-43 Watershed: ☐ Yes ☑ No

OWNER OR CONTRACTOR Chris Barlett PHONE: Business _____ Home 838 0647

ADDRESS 118 [redacted] Henderson Dr

LOCATION 702 TR Shiloh Rd Cross 3rd creek 1/4mi TR Henderson Dr. 1st lot RD

SUBDIVISION Henderson BLOCK / SECTION _____ LOT 204 LOT AREA _____ SITE CLASS. _____ DESIGN FLOW _____ L.T.A.R. _____


| | | | |
|---|---|---|---|
| Septic Tank: _____ Gallons; STB _____ Date _____ | ☐ New System ☐ Repair System Type: I, II, III, IV, V, VI | ☐ House/Mod. Home No. Bedrooms 2 | Water Supply: |
| Pump Tank: _____ Gallons; PT _____ Date _____ | System Description: _____ | ☑ Mobile Home No. Bathrooms 1 | ☐ Individual |
| Pump Make: _____ Model _____ Serial No. _____ | Repair System Description: _____ | ☐ Business No. Employees _____ | ☑ Community |
| Nitrification Field: No Lines _____ Square Feet _____ Linear Feet _____ | Maintenance Agreement Required. ☐ Yes ☐ No | ☐ Other _____ | ☐ Public |
| No Lines _____ Trench Width _____ Max Trench Bottom Depth _____ | Gravel Depth _____ | ☐ Slab ☐ Crawl Space ☐ Basement w/plumbing ☐ Basement wo/plumbing | |

Comments:

Comments:

**INITIAL SITE SKETCH**

**AS BUILT SKETCH**

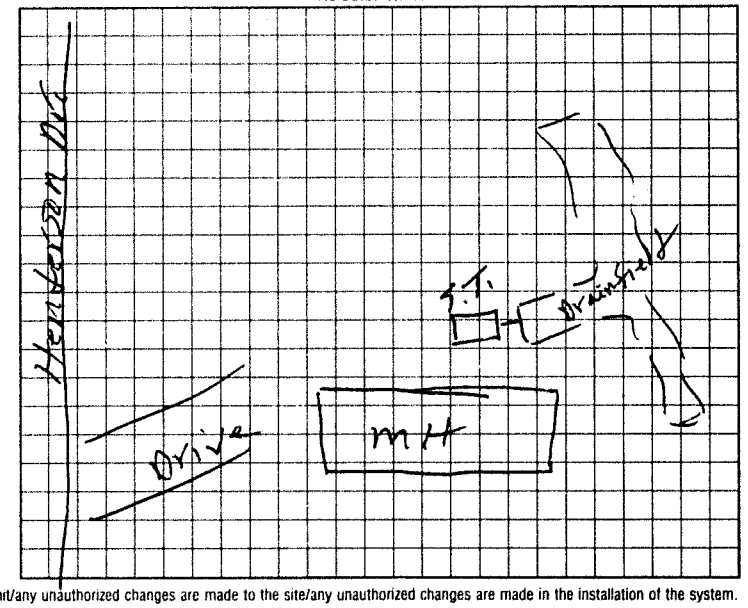


I understand that this permit can be suspended or revoked if any false information is supplied toward securing the permit/any unauthorized changes are made to the site/any unauthorized changes are made in the installation of the system. Improvement Permit is valid for 60 months from date of issuance.

Signed: _____ Installed by: _____

Improvement Permit by: _____ date _____ Certificate of Completion by: _____ date _____

Existing System Inspection by: P. C. Moore date 4-18-94 Operation Permit by: _____ date _____

HEALTH DEPT. COPY: WHITE INSPECTION COPY (FINAL): GREEN OWNER COPY (FINAL): YELLOW INSPECTION COPY (INITIAL): PINK OWNER COPY (INITIAL): GOLD