IREDELL COUNTY HEALTH DEPARTMENT

Statesville Office (704) 878-5305 Mooresville Office (704) 660-3625 PERMIT # 222485

IMPROVEMENT PERMIT / AUTHORIZATION TO CONSTRUCT / OPERATION PERMIT / EXISTING SYSTEM

PIN # 4752 6700 86.153

APPLICANT: Kim Carter APPLICANT ADDRESS: 141 Henderson Dr Statesville N.C

SITE ADDRESS: 153 Henderson Dr - Statesville NC PHONE: 954-465-905 ALT. PHONE: 954-471-4422

SITE DIRECTIONS: from 70 to Shiloh to henderson lot on left

SUBDIVISION: Rolling Hills MHP SECTION: / LOT # 153 LOT AREA: 13.52ac DESIGN FLOW: 360 L.T.A.R.: Ex

Septic Tank	Ex (gal)	STB		Date	
Pump Tank	(gal)	PT		Date	
Pump Make		Model		Serial #	
# Nitrification Fields	Ex	# Lines	Ex	Linear Ft:	Ex
Trench Width	Ex	Max. Trench Bottom Depth	Ex	Gravel Depth	Ex

☐ New System ☐ Repair ☐ Expansion System Type: I ☒ II III IV V VI

System Description: Existing

Repair System Description:

Maintenance Agreement Required: ☐ YES ☒ NO

☒ GRAVITY ☐ PRESSURE

☒ Residence ☐ Business ☐ Other ☐ Slab ☐ Basement w/plumbing

No. Bedrooms 3 No. Persons 6 No. Employees


☒ Crawl Space ☐ Basement w/o plumbing

Water Supply: ☐ Private ☐ Public ☒ Community

Comments / Conditions: All building foundations must be 35' from any part of STs

INITIAL SITE SKETCH

AS BUILT SKETCH

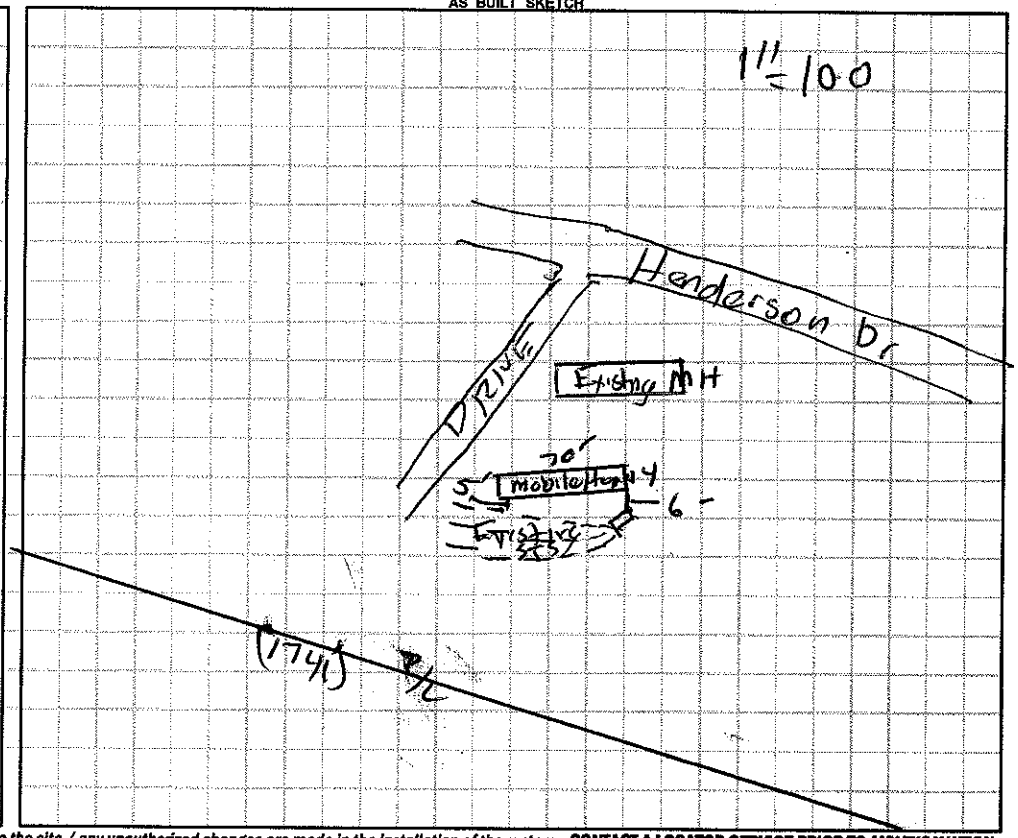

Permit can be suspended or revoked if any false information is supplied toward securing the permit / any unauthorized changes are made to the site / any unauthorized changes are made in the installation of the system. **CONTACT A LOCATOR SERVICE PRIOR TO ANY EXCAVATION**

☐ **IMPROVEMENT PERMIT** ***with plat*** *valid without expiration.* ☐ **IMPROVEMENT PERMIT** ***with site plan*** *valid for 60 mos.* ☐ **AUTHORIZATION TO CONSTRUCT** *valid for period equal to IMPROVEMENT PERMIT--not to exceed 60 mo.*

Owner / Applicant Signature: Nancy Armstrong Date: Installed by:

IMPROVEMENT PERMIT by: Date: OPERATION PERMIT by: Date:

AUTHORIZATION TO CONSTRUCT by: Date: Existing System Inspected by: Date: 11/4/16

Health Dept. Copy - WHITE Applicant (Final Approval) - YELLOW Applicant (Conditional Approval) - PINK