IREDELL COUNTY HEALTH DEPARTMENT

STATESVILLE 704-878-5305 MOORESVILLE 704-664-5281

IMPROVEMENT PERMIT / CERTIFICATE OF COMPLETION / OPERATION PERMIT / EXISTING SYSTEM INSPECTION

PROPERTY DESCRIPTION NO. 23042 DATE 1-24-96 TAX MAP NO 5K-A-43 Watershed: Yes No

OWNER OR CONTRACTOR Jerry Hogan PHONE Business Home 704 275 4862

ADDRESS 113 Henderson Dr. Sta. N.C. Dr.

LOCATION 70E TR Shiloh Ch Rd TR Henderson Dr 1st mtt left

SUBDIVISION Henderson MHP BLOCK / SECTION LOT 203 LOT AREA SITE CLASS DESIGN FLOW L T A R

Septic Tank: Gallons; STB Date
Pump Tank: Gallons; PT Date
Pump Make: Model Serial No
Nitrification Field: No Fields Square Feet Linear Feet
No Lines Trench Width Max Trench Bottom Depth Gravel Depth

New System Repair System Type I II III IV V VI
System Description
Repair System Description
Maintenance Agreement Required Yes No
Slab Crawl Space Basement w/plumbing Basement wo/plumbing

House/Mod Home No Bedrooms 2
Mobile Home No Bathrooms 2
Business No Employees
Other


Water Supply
Individual
Community
Public

Comments:

Comments

INITIAL SITE SKETCH

AS BUILT SKETCH

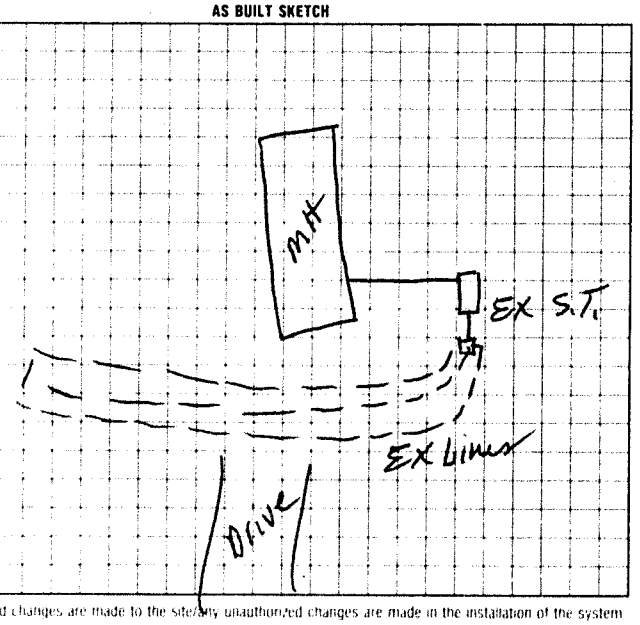

I understand that this permit can be suspended or revoked if any false information is supplied toward securing the permit, any unauthorized changes are made to the site, any unauthorized changes are made in the installation of the system

Signed

Improvement Permit by date

Existing System Inspection by: L.C. Moore date 1-24-96

Installed by

Certificate of Completion by date

Operation Permit by date

HEALTH DEPT COPY WHITE INSPECTION COPY (FINAL) GREEN OWNER COPY (FINAL) YELLOW INSPECTION COPY (INITIAL) PINK OWNER COPY (INITIAL) GOLD