IREDELL COUNTY HEALTH DEPARTMENT

STATESVILLE 704-878-5305 MOORESVILLE 704-664-5281

IMPROVEMENT PERMIT / AUTHORIZATION TO CONSTRUCT / OPERATION PERMIT / EXISTING SYSTEM INSPECTION

PERMIT# 75494 PIN# 4752670086

OWNER OR CONTRACTOR Wade Henderson PHONE: Business 873 5128 Home DATE 8-18-98

ADDRESS 125 Henderson Dr.

LOCATION 70 E TR Shiloh Rd TR Henderson Dr at end Rt.

SUBDIVISION Henderson MHP BLOCK / SECTION LOT 29 LOT AREA acreage SITE CLASS. PS DESIGN FLOW 240 L.T.A.R. .3

Septic Tank: 1000 Gallons; STB 794 Date 6-11-98

Pump Tank: Gallons; PT Date

Pump Make: Model Serial No.

Nitrification Field: No Fields 1 Square Feet 600 Linear Feet 200

No Lines 3 Trench Width 36 Max Trench Bottom Depth 24"

☑ New System ☐ Repair System Type: I, II, III, IV, V, VI

System Description: Gravity chambers

Repair System Description: LPP

Maintenance Agreement Required: ☐ Yes ☑ No

Gravel Depth N/A

☐ House/Mod. Home ☑ Mobile Home ☐ Business ☐ Other

No. Bedrooms 2 No. Bathrooms 2 No. Employees

☐ Slab ☑ Crawl Space ☐ Basement w/plumbing ☐ Basement wo/plumbing

Water Supply: ☐ Individual ☐ Public ☑ Community


Comments:/Conditions:

Creek

Comments:/Conditions:

9/8 system kept shallow
Need to install Fren

INITIAL SITE SKETCH

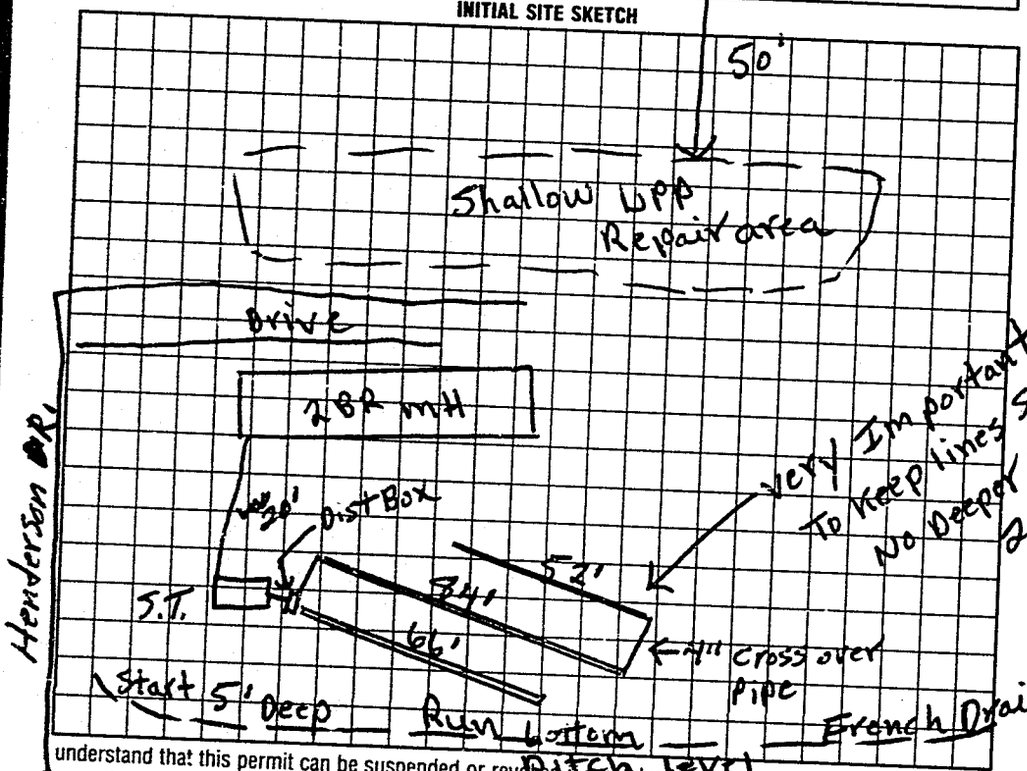

AS BUILT SKETCH

I understand that this permit can be suspended or revoked if any false information is supplied toward securing the permit/any unauthorized changes are made to the site/any unauthorized changes are made in the installation of the system. Improvement Permit with plat valid without expiration. Improvement Permit with site plan valid for sixty months. Authorization to Construct is valid for a period equal to that of Improvement Permit – not to exceed sixty months.

Signed: Judy Henderson date 8-21-98

Improvement Permit by: L. C. Moore date 8-18-98

Authorization to Construct by: L. C. Moore date 8-18-98

Installed by: James Hutler

Operation Permit by: L. C. Moore date 9-11-98

Existing System Inspection by: date

HEALTH DEPT. COPY: WHITE INSPECTION COPY (FINAL): GREEN OWNER COPY (FINAL): YELLOW INSPECTION COPY (INITIAL): PINK OWNER COPY (INITIAL): GOLD