IREDELL COUNTY HEALTH DEPARTMENT

Statesville Phone TR 3-7271 Mooresville Phone NO 3-1271

PERMIT TO INSTALL SEPTIC TANK

Permit No. 383 Permit Date Nov. 6 1970

Owner MR. WADE HENDERSON Address STATESVILLE, N.C. R.7

Installed By Mr. WADE HENDERSON Address " " "


Location of Property HIGHWAY 70 EAST - TURN RIGHT ON Road # 2318 - SHILOH METH. CHURCH ROAD - CROSS CREEK. TURN RIGHT BETWEEN 2ND + 3RD HOUSE.

Tank		Capacity		Length of Lines		Fixtures	
Block	( )	1000	(✓)	225'	( )	No. of Baths	(2)
Precast	(✓)	1250	( )	250'	( )	Dishwasher	( )
		1500	( )	Other 350		Garbage Grdr.	( )
		Other				Other	

NOTIFY HEALTH DEPARTMENT AT LEAST EIGHT HOURS BEFORE TANK IS TO BE INSPECTED.

Final Inspection Nov. 6 1970 Approved (✓) Disapproved ( )

Remarks WATER SUPPLY FURNISHED BY J. ALEX EDMISTON WELL EAST OF PROPERTY

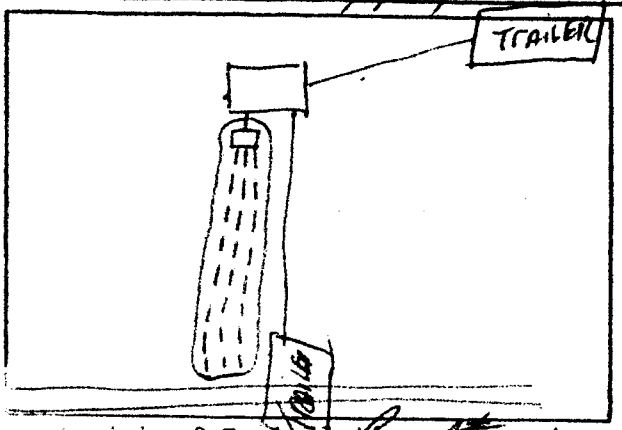

Sketch of Installation

Sanitarian