IREDELL COUNTY HEALTH DEPARTMENT

STATESVILLE 704-878-5305 (ad) MOORESVILLE 704-664-5281

IMPROVEMENT PERMIT / AUTHORIZATION TO CONSTRUCT / OPERATION PERMIT / EXISTING SYSTEM INSPECTION

PERMIT # 152308 PIN # 4752-67-0086 DATE 2-25-09

OWNER or APPLICANT Volkmar Dirksen PHONE: Business Home: 954-465 9051

OWNER or APPLICANT ADDRESS 16950 NE 7th Ave. Boca Raton, FL 33487

LOCATION / DIRECTIONS 70E (R) Shiloh (R) Henderson Drive 138 on Right

SUBDIVISION Rolling Hill estates BLOCK / SECTION LOT # 138 LOT AREA DESIGN FLOW 240 L.T.A.R. Exist

Septic Tank 1000 Gallons: STB Date

Pump Tank Gallons: P T Date

Pump Make Model Serial #

Nitrification Field No Fields No Lines 2 Linear Feet Exist

Trench Width Exist Max. Trench Bottom Depth Exist Gravel Depth N/A

~~New System~~ Exist ☐ Repair ☐ Expansion System Type I II III IV V VI

System Description: Conventional

Repair System Description: 50% Low Pressure

Maintenance Agreement Required ☐ YES ☒ NO

☐ GRAVITY ☐ PRESSURE

☒ Residence No. Bedrooms 2 ☐ Business No. Persons ☐ Other No. Employees ☐ Slab ☒ Crawl Space ☐ Basement w/plumbing ☐ Basement w/o plumbing


Water Supply: ☐ Private ☐ Public ☒ Community

Comments / Conditions

Comments / Conditions

INITIAL SITE SKETCH

AS BUILT SKETCH

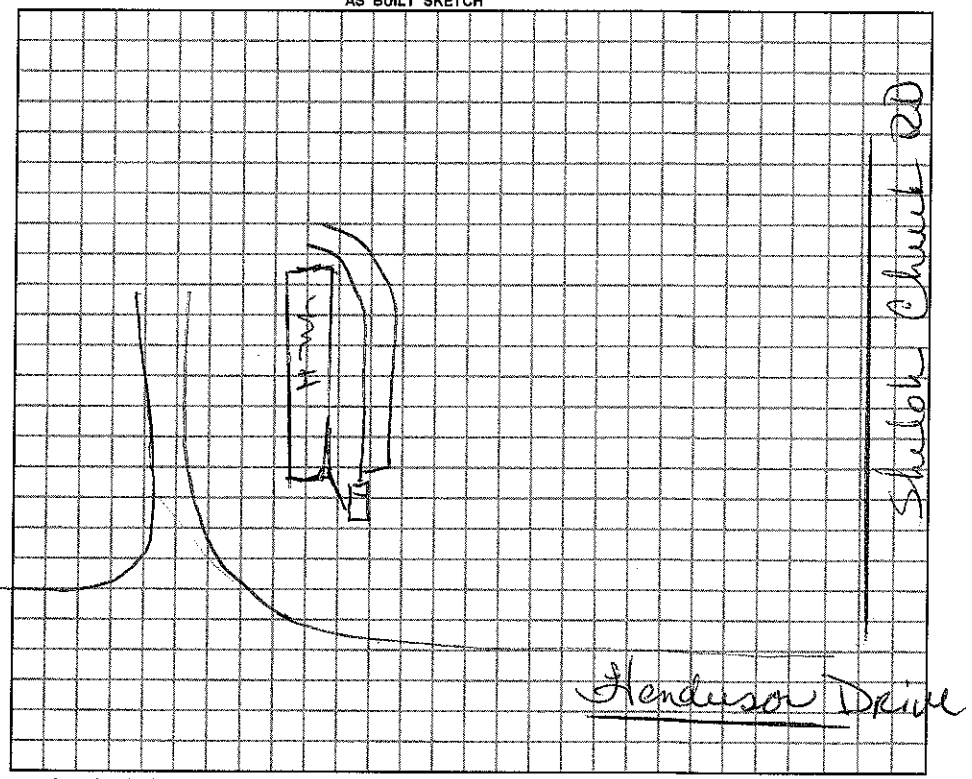

Permit can be suspended or revoked if any false information is supplied toward securing the permit / any unauthorized changes are made to the site / any unauthorized changes are made in the installation of the system.

☐ *IMPROVEMENT PERMIT w / plat valid without expiration.* ☐ *IMPROVEMENT PERMIT w / site plan valid for 60 mos.* ☑ *AUTHORIZATION TO CONSTRUCT valid for period equal to IMPROVEMENT PERMIT-not to exceed 60 mo.*

Owner / Applicant Signature: Date

Improvement Permit by: Date

Authorzation to Construct by: Date

YOU SHOULD CONTACT A LOCATOR SERVICE PRIOR TO ANY EXCAVATION.

Installed by:

Operation Permit by: Date:

Existing System Inspected by: Date: 2-25-09

WHITE COPY Environmental Health YELLOW COPY (Final) Owner / Applicant PINK COPY (Initial) Owner / Applicant