IREDELL COUNTY HEALTH DEPARTMENT

Statesville Office (704) 878-5305 Mooresville Office (704) 660-3625 PERMIT # 226323

IMPROVEMENT PERMIT / AUTHORIZATION TO CONSTRUCT / OPERATION PERMIT / EXISTING SYSTEM

PIN # 4752670086

APPLICANT: Kim Carter APPLICANT ADDRESS: 141 Henderson Drive Statesville NC 28677

SITE ADDRESS: 70E to Shiloh RD Right on Henderson. PHONE: 954 465 9051 ALT. PHONE: —

SITE DIRECTIONS: 128 Henderson Drive

SUBDIVISION: Rolling Hills Mobile Home Park SECTION: — LOT # 128 LOT AREA: — DESIGN FLOW: 240 L.T.A.R.: EXT

Septic Tank EXT (gal) STB Date

Pump Tank (gal) PT Date

Pump Make Model Serial #

Nitrification Fields EXT # Lines EXT Linear Ft: EXT

Trench Width EXT Max. Trench Bottom Depth EXT Gravel Depth EXT

☐ New System ☐ Repair ☐ Expansion System Type: I II III IV V VI

System Description: Existing

Repair System Description:

Maintenance Agreement Required: ☐ YES ☒ NO

☒ GRAVITY ☐ PRESSURE

☒ Residence No. Bedrooms 2

☐ Business No. Persons

☐ Other No. Employees

☐ Slab ☒ Crawl Space

☐ Basement w/plumbing ☐ Basement w/o plumbing

Water Supply


☐ Private

☒ Public

☐ Community

Comments / Conditions: Maintain offsets from Septic System.

INITIAL SITE SKETCH

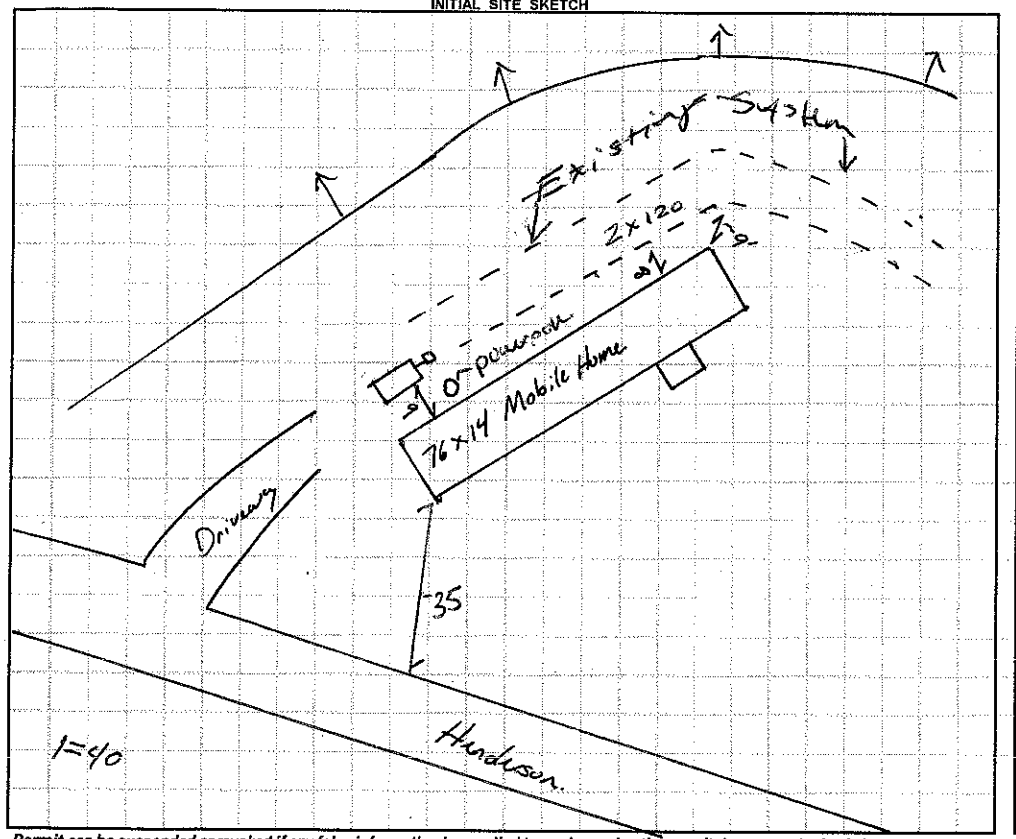

AS BUILT SKETCH

Permit can be suspended or revoked if any false information is supplied toward securing the permit / any unauthorized changes are made to the site / any unauthorized changes are made in the installation of the system. **CONTACT A LOCATOR SERVICE PRIOR TO ANY EXCAVATION**

☐ **IMPROVEMENT PERMIT** ***with plat*** *valid without expiration.* ☐ **IMPROVEMENT PERMIT** ***with site plan*** *valid for 60 mos.* ☐ **AUTHORIZATION TO CONSTRUCT** *valid for period equal to IMPROVEMENT PERMIT--not to exceed 60 mo.*

Owner / Applicant Signature: Kim Carter Date: 5-25-17 Installed by:

IMPROVEMENT PERMIT by: Date: OPERATION PERMIT by: Date:

AUTHORIZATION TO CONSTRUCT by: Date: Existing System Inspected by: Benjamin A. Benfield Date: 5/22/2017

Health Dept. Copy - WHITE Applicant (Final Approval) - YELLOW Applicant (Conditional Approval) - PINK