IREDELL COUNTY HEALTH DEPARTMENT

STATESVILLE 704-878-5305 ✓ MOORESVILLE 704-664-5281

IMPROVEMENT PERMIT / AUTHORIZATION TO CONSTRUCT / OPERATION PERMIT / EXISTING SYSTEM INSPECTION

PERMIT# 104765 PIN# 4752-67-0086 DATE 2/22/02

OWNER OR CONTRACTOR Wade Henderson PHONE: Business (704) 873-5128 Home same

ADDRESS 125 Henderson Drive Statesville N.C. 28677

LOCATION I-77 South ⑤ Amity Hill ② Shiloh Rd ⑤ Henderson Pine on Left @ End.

SUBDIVISION Henderson MHP BLOCK / SECTION — LOT #24 LOT AREA 13.52 ac. mhp SITE CLASS 15 DESIGN FLOW 360 L.T.A.R. Existing

Septic Tank Existing 600 Gallons: STB — Date —
Pump Tank: ____ Gallons, PT ____ Date ____
Pump Make: ____ Model ____ Serial No. ____
Nitrification Field: No Fields 1 Square Feet 720 Linear Feet 240
No Lines ____ Trench Width ____ Max Trench Bottom Depth ____ Gravel Depth ____

☐ New System ☐ Repair System Type: I. II. III. IV. V. VI
System Description: Existing
Repair System Description: ____
Maintenance Agreement Required: ☐ Yes ☒ No

☐ House/Mod. Home ☒ Mobile Home ☐ Business ☐ Other
No. Bedrooms 3 No. Bathrooms 2 No. Employees ____

☐ Slab ☒ Crawl Space ☐ Basement w/plumbing ☐ Basement wo/plumbing


Water Supply: ☐ Individual ☒ Public ☒ Community

Comments/Conditions:

Comments/Conditions: Existing System okay @ time of Inspection.

INITIAL SITE SKETCH

AS BUILT SKETCH

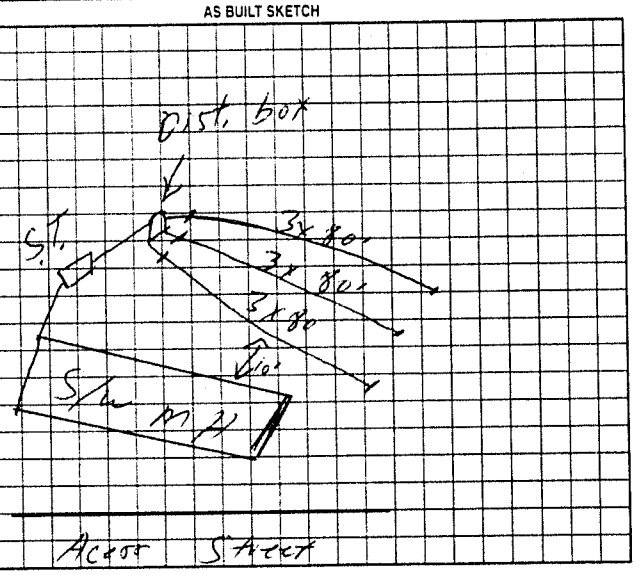

Permit can be suspended or revoked if any false information is supplied toward securing the permit/any unauthorized changes are made to the site/any unauthorized changes are made in the installation of the system. Improvement Permit with plat valid without expiration. Improvement Permit with site plan valid for sixty months. Authorization to Construct is valid for a period equal to that of Improvement Permit – not to exceed sixty months.

Signed: ____ date ____

Improvement Permit by: ____ date ____

Authorization to Construct by: ____ date ____

Installed by: ____

Operation Permit by: ____ date ____

Existing System Inspection by: William O. Johnson date 2/22/02

HEALTH DEPT. COPY: WHITE OWNER COPY (FINAL) YELLOW OWNER COPY (INITIAL) PINK