IREDELL COUNTY HEALTH DEPARTMENT

STATESVILLE 704-878-5305 MOORESVILLE 704-664-5281 ad

IMPROVEMENT PERMIT / AUTHORIZATION TO CONSTRUCT / OPERATION PERMIT / EXISTING SYSTEM INSPECTION

PERMIT # 5602000 PIN # 4752-67-0086 DATE 5-7-09

OWNER or APPLICANT Kim Carter PHONE: Business Home:

OWNER or APPLICANT ADDRESS 113 Henderson Drive Statesville NC

LOCATION / DIRECTIONS 70 E to Shiloh Church RD 1/2 mile on right

SUBDIVISION Henderson Mobile Park BLOCK / SECTION LOT # 113 LOT AREA 13.72 DESIGN FLOW 240 L.T.A.R. 0.6+

Septic Tank EXIST 1250 Gallons: STB Date

Pump Tank Gallons: P T Date

Pump Make Model Serial #

Nitrification Field No Fields No Lines Linear Feet EXIST 500

Trench Width EXIST Max. Trench Bottom Depth EXIST Gravel Depth GRAVITY PRESSURE

~~New System~~ Exist Repair Expansion System Type I II III IV V VI

~~System~~ Description:

Repair System Description:

Maintenance Agreement Required YES NO

Residence No. Bedrooms 2

Business No. Persons

Other No. Employees

Slab Crawl Space

Basement w/plumbing Basement w/o plumbing

Water Supply: Private Public Community


Comments / Conditions

Septem is Very Deep

Comments / Conditions

INITIAL SITE SKETCH

AS BUILT SKETCH

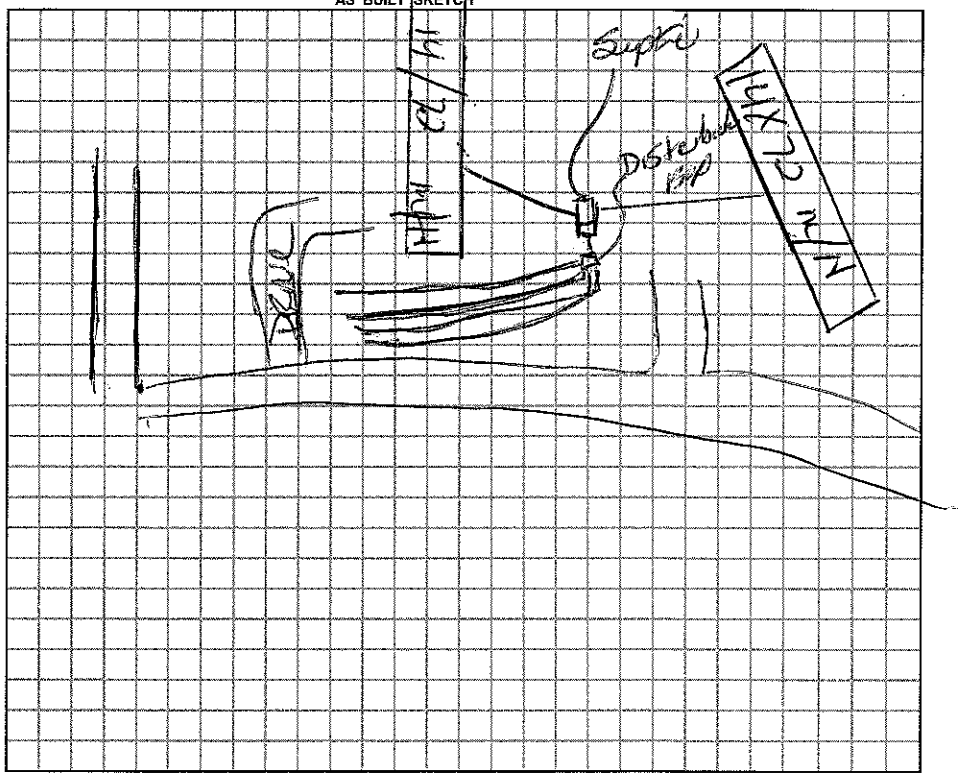

Permit can be suspended or revoked if any false information is supplied toward securing the permit / any unauthorized changes are made to the site / any unauthorized changes are made in the installation of the system.

☐ *IMPROVEMENT PERMIT w / plat valid without expiration.* ☐ *IMPROVEMENT PERMIT w / site plan valid for 60 mos.* ☐ *AUTHORIZATION TO CONSTRUCT valid for period equal to IMPROVEMENT PERMIT-not to exceed 60 mo.*

Owner / Applicant Signature: Date

Improvement Permit by: Date

Authorization to Construct by: Date

YOU SHOULD CONTACT A LOCATOR SERVICE PRIOR TO ANY EXCAVATION.

Installed by:

Operation Permit by: Date:

Existing System Inspected by: Date: 5-7-09

WHITE COPY Environmental Health YELLOW COPY (Final) Owner / Applicant PINK COPY (Initial) Owner / Applicant