IREDELL COUNTY HEALTH DEPARTMENT

IMPROVEMENT PERMIT / AUTHORIZATION TO CONSTRUCT / OPERATION PERMIT / EXISTING SYSTEM INSPECTION

STATESVILLE 704-878-5305 MOORESVILLE 704-664-5281

PERMIT# 42384 PIN# 4752670064

OWNER OR APPLICANT Jennifer Lipsey PHONE: Business _____ Home _____ DATE 10 May 07

ADDRESS 670E Broad St. Suite 208 Statesville NC 28625

LOCATION 210E (HD Shiloh (HD Henderson Trailer on Right

SUBDIVISION Henderson MHP BLOCK / SECTION _____ LOT 40 LOT AREA 15,000 SITE CLASS. 5

Septic Tank: Exist Gallons: STB _____ Date _____

Pump Tank: _____ Gallons: PT _____ Date _____

Pump Make: _____ Model _____ Serial No. _____

Nitrification Field: No Fields ___ Square Feet 600 Linear Feet 200

No Lines 2 Trench Width 6" Max Trench Bottom Depth 36"

Gravel Depth 12

☑ New System ☐ Repair ☐ Expansion System Type: I II III IV V VI

System Description: Existing

Repair System Description: _____

Maintenance Agreement Required: ☐ Yes ☐ No

☐ Gravity ☐ Pressure ☐ Slab ☑ Crawl Space ☐ Basement w/plumbing ☐ Basement wo/plumbing

☐ House/Mod. Home ☑ Mobile Home ☐ Business ☐ Other

No. Bedrooms 3 No. Persons ___ No. Employees ___

Water Supply: ☐ Individual ☑ Public ☐ Community


Comments/Conditions:

Trailer park now named Rolling Hill estates -

Comments/Conditions:

INITIAL SITE SKETCH

AS BUILT SKETCH

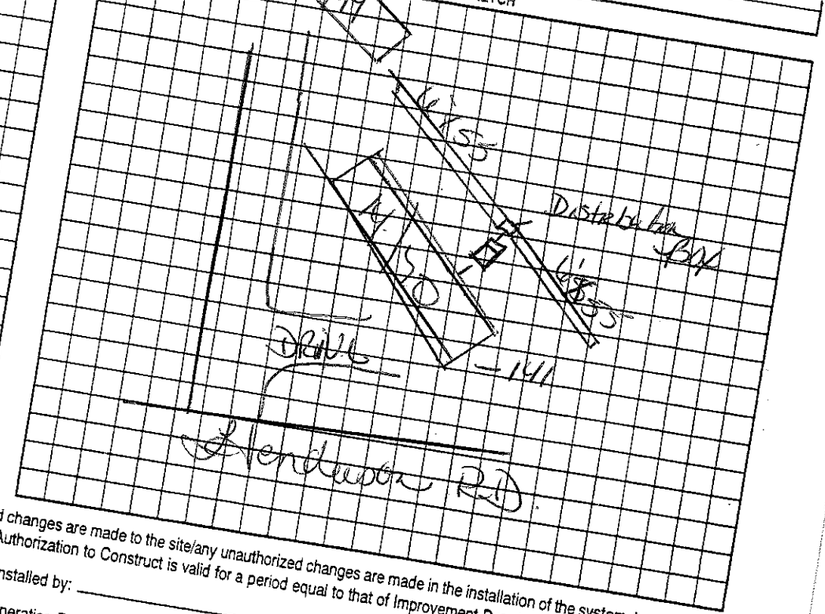

Permit can be suspended or revoked if any false information is supplied toward securing the permit/any unauthorized changes are made to the site/any unauthorized changes are made in the installation of the system. Improvement Permit with plat valid without expiration ☐ Improvement Permit with site plan valid for sixty months ☐ Authorization to Construct is valid for a period equal to that of Improvement Permit – not to exceed sixty months.

Signed: _____ Installed by: _____

Improvement Permit by: _____ date _____ Operation Permit by: _____ date _____

Authorization to Construct by: _____ date _____ Existing System Inspection by: Kelly Cook date 10 May 07

HEALTH DEPT. COPY: WHITE OWNER COPY (FINAL): YELLOW OWNER COPY (INITIAL): PINK