IREDELL COUNTY HEALTH DEPARTMENT

Statesville Phone TR 3-7271 Mooresville Phone NO 3-1271

PERMIT TO INSTALL SEPTIC TANK

Permit NO. _____ Permit Date Jan 27 1965

Owner Paul Munday Address R7

Installed By C Hoke Address R7


Location of Property out Amity Hill Rd. 1st Lane to left. 2318 - go ½ mile on R.

Tank	Capacity	Length of Lines	Fixtures
Block ( )	800 ( )	150' ( )	No. of Baths (1)
Precast (→)	900 ( )	175' ( )	Dishwasher ( )
	1000 (→)	200' ( )	Garbage Grdr. ( )
	1100 ( )	225' (→)	Auto-Washer (→)
	1200 ( )	250' ( )	Other _____
	Other _____	Other _____	

NOTIFY HEALTH DEPARTMENT AT LEAST EIGHT HOURS BEFORE TANK IS TO BE INSPECTED.

Final Inspection 1-27 1965 Approved (✓) Disapproved ( )

Remarks Central water supply.

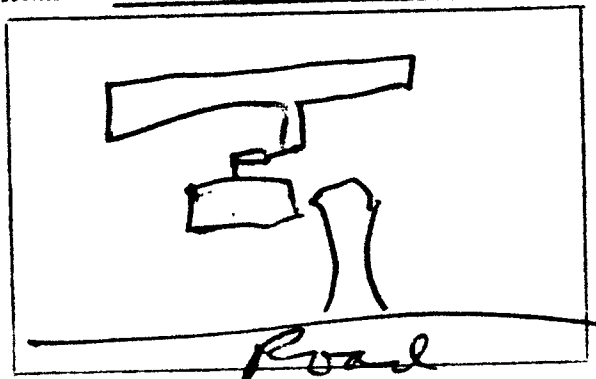

Sketch of Installation

Sanitarian