IREDELL COUNTY HEALTH DEPARTMENT

STATESVILLE 704-878-5305 (C1) MOORESVILLE 704-664-5281

IMPROVEMENT PERMIT / AUTHORIZATION TO CONSTRUCT / OPERATION PERMIT / EXISTING SYSTEM INSPECTION

(C) PERMIT# 11392 PIN# 4752-73-2796 DATE 3-10-03

OWNER OR CONTRACTOR CYNTHIA MORRIS PHONE: Business Home 704-528-3520

ADDRESS 733 SHILOH ROAD, STATESVILLE, NC 28625

LOCATION US 70 EAST, TR SHILOH ROAD, 1ST LOT ON LEFT PAST CLEMMENTS ROAD

SUBDIVISION BLOCK / SECTION LOT LOT AREA 4.43 ACRES SITE CLASS. PS DESIGN FLOW 360 L.T.A.R. 0.30 GPD/FT

Septic Tank: 1000 Gallons; STB C020 Date 8-3-02
Pump Tank: Gallons; PT Date
Pump Make: Model Serial No.
Nitrification Field: No Fields 1 Square Feet 1200 Linear Feet 400
No Lines FOUR Trench Width 36" Max Trench Bottom Depth 36" Gravel Depth 12"

☑ New System ☐ Repair System Type: I (II) III. IV. V. VI
System Description: CONVENTIONAL, GRAVITY
Repair System Description: CONVENTIONAL, GRAVITY
Maintenance Agreement Required: ☐ Yes ☑ No


☑ House/Mod. Home No. Bedrooms 3
☐ Mobile Home No. Bathrooms 2
☐ Business No. Employees
☐ Other
☐ Slab ☐ Crawl Space ☑ Basement w/plumbing ☑ Basement wo/plumbing

Water Supply: ☑ Individual ☐ Public ☐ Community WELL


Comments/Conditions: KEEP SYSTEM MINIMUM 100 FEET FROM WELL, 15' FROM BASEMENT FOUNDATION DRAIN, 15' FROM TOP OF CUT OR EMBANKMENT

Comments/Conditions: SEPTIC TANK WITH MARKER INSTALLED USING "ZABEL" FILTER.

INITIAL SITE SKETCH SCALE: 1"=50'

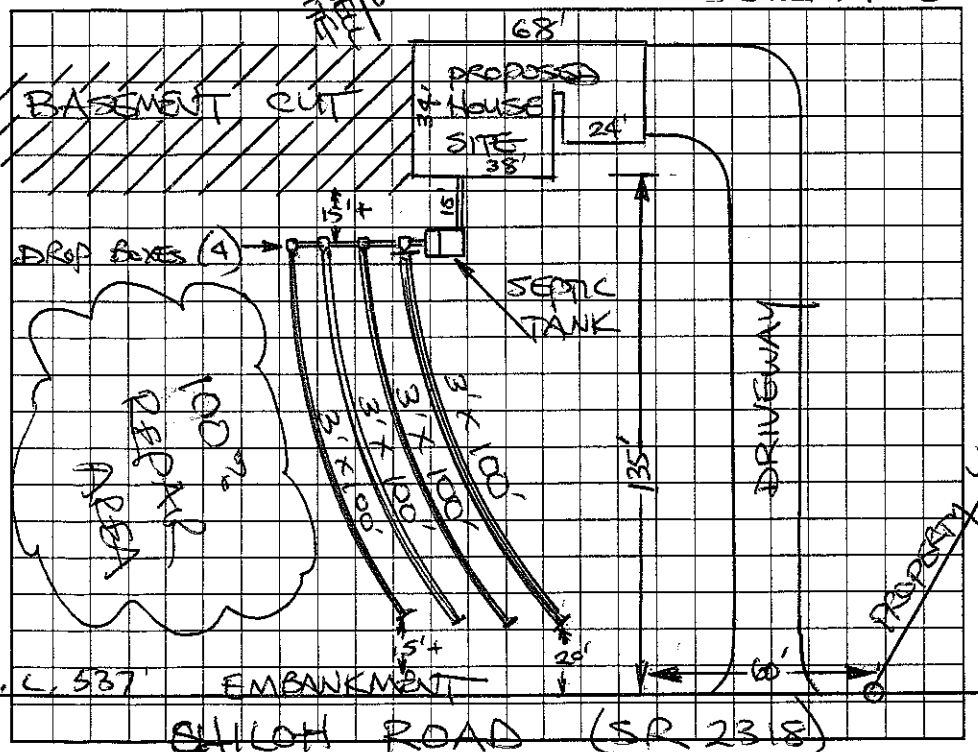

AS BUILT SKETCH

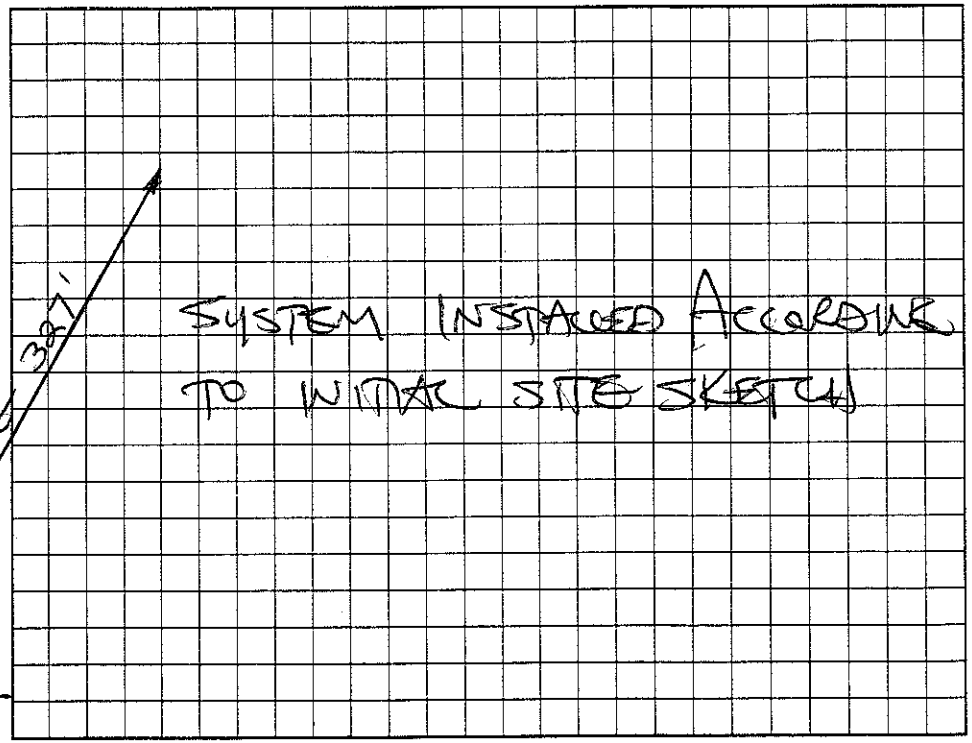

Permit can be suspended or revoked if any false information is supplied toward securing the permit/any unauthorized changes are made to the site/any unauthorized changes are made in the installation of the system. Improvement Permit with ~~plat~~ valid without expiration. Improvement Permit with site plan valid for sixty months. Authorization to Construct is valid for a period equal to that of Improvement Permit – not to exceed sixty months.

Signed: [signature] date 3-10-03 Installed by: SAMMY REAVIS

Improvement Permit by: STEVE HEDRICK date 3-10-03 Operation Permit by: STEVE HEDRICK date 8-27-03

Authorization to Construct by: STEVE HEDRICK date 3-10-03 Existing System Inspection by: date

HEALTH DEPT. COPY: WHITE OWNER COPY (FINAL): YELLOW OWNER COPY (INITIAL): PINK