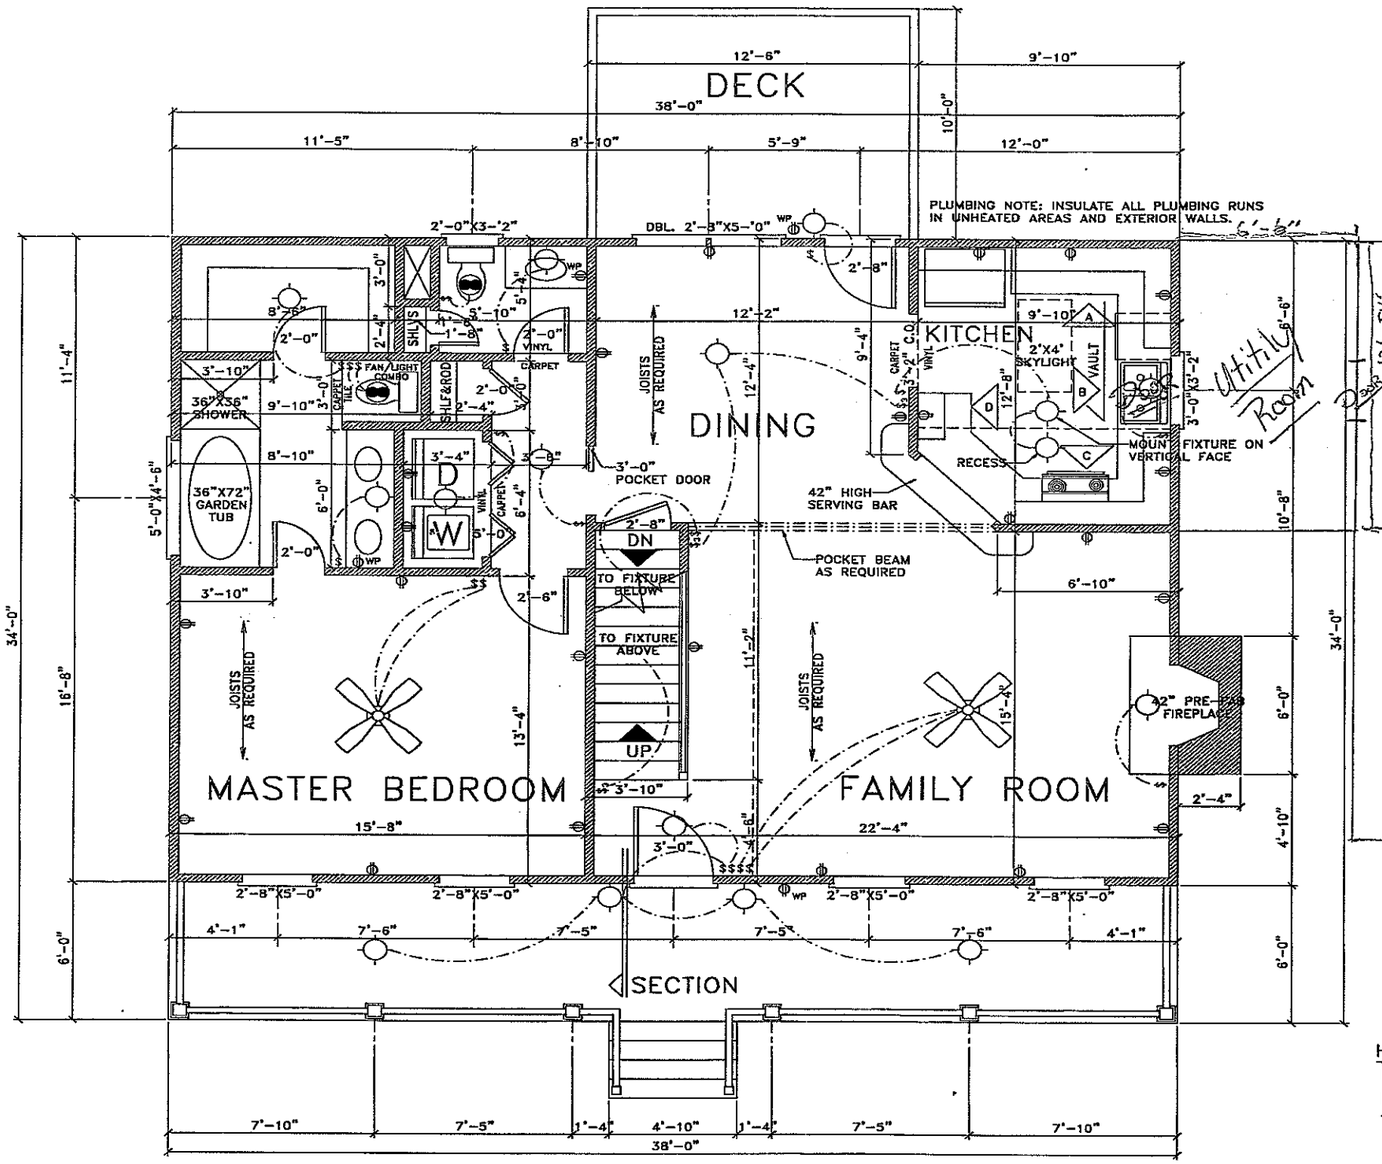


LOWER LEVEL FLOOR PLAN

SCALE: 1/4"=1'

Upper Level	579	sq.ft.
Lower Level	1146	sq.ft
Basement	1146	sq.ft
Garage	624	sq.ft
Storage/Bonus	280	sq.ft
Porch	228	sq. ft.

Total sq. ft under roof > 4003 sq.ft.

HEATED SQUARE FOOTAGE	
UPPER LEVEL	579
LOWER LEVEL	~~1064~~ 1146
TOTAL	~~1643~~ 1725

PLEAE Note *

Acknowledgement Of Plans Submittal ONLY!

STEVE HEDRICK Date 3-10-03

Dave Williams Date 3-10-03


Utility room added onto home adding 82 sq.ft. to lower level and 82 sq.ft. to basement area

Garage

All plans are copyrighted by Atlanta Plan Source, Inc. and/or Designer
Atlanta PLAN SOURCE INCORPORATED
P.O. Box 1169
Alpharetta, GA 30009
Ph: 770-664-4114
DO NOT COPY WITHOUT WRITTEN COPYRIGHT RELEASE

Note: Great care and effort have gone into the creation of the designs and engineering of these plans. However, because of the impossibility of predicting the many conditions of the site, soil, and construction methods, and because of the impossibility of predicting the many variations in local building code requirements and other possible actual construction and because of the possibility of human error, Atlanta Plan Source, Inc. assumes no responsibility for any damages, including structural failures due to any deficiencies, omissions, or errors in the design, in any ordinance, the maximum liability of Atlanta Plan Source, Inc. shall be a refund of the purchase price of the home plans. These home plans are designed to meet the requirements of the 2000 International Residential Code. You should consult with your local building officials prior to the start of actual construction. Additional engineering may be required to comply with seismic, wind, or other special conditions as required by local building codes.

IF THIS STAMP IS NOT RED IT IS AN ILLEGAL SET OF PLANS
REPRODUCTION OF THESE PLANS BY ANY MEANS IS PROHIBITED BY FEDERAL LAW. VIOLATORS ARE PUNISHABLE BY FINES UP TO $100,000 PER OFFENSE
TO $100,000 PER OFFENSE
CALL THE DESIGNER TO OBTAIN LEGAL COPIES OF THIS PLAN

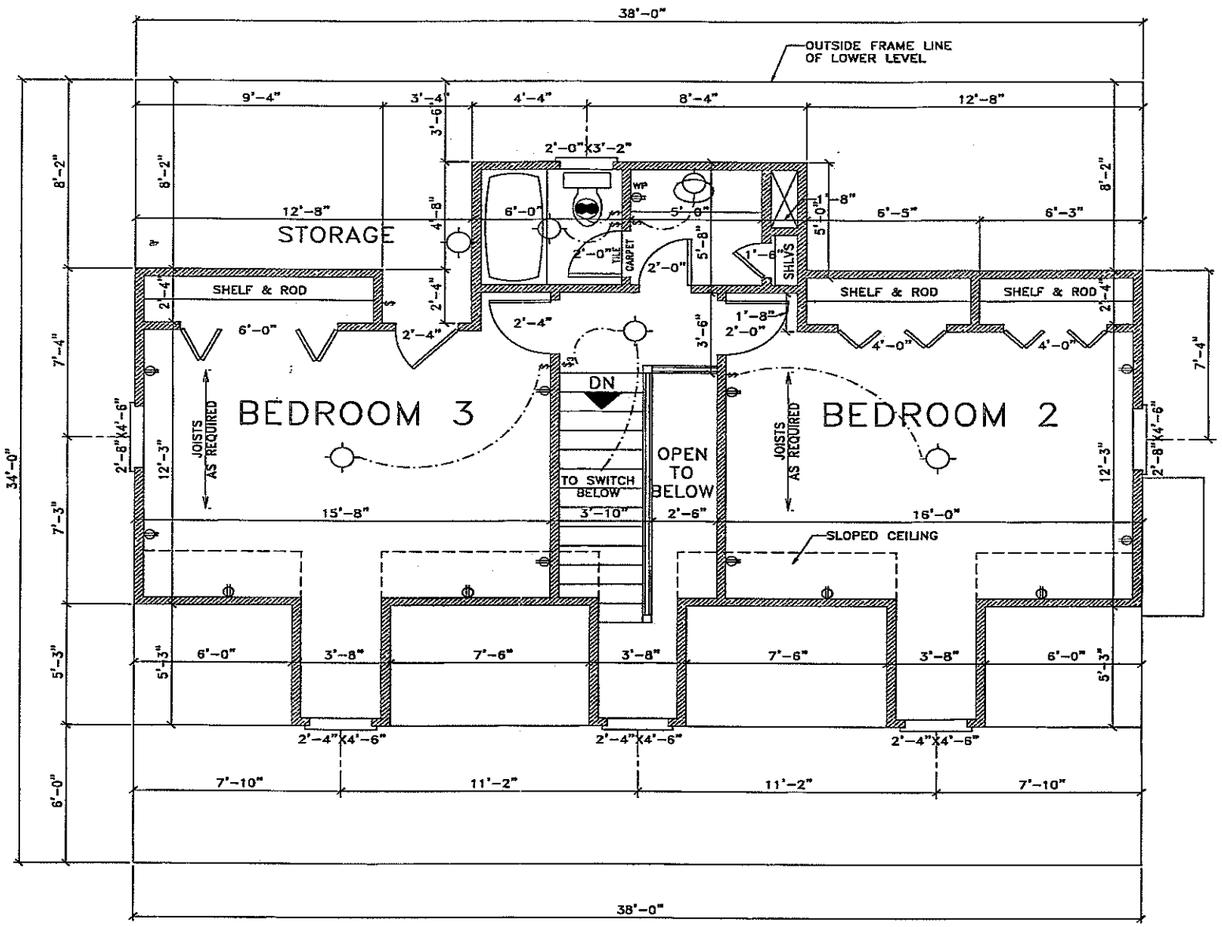

UPPER LEVEL FLOOR PLAN
SCALE: 1/4"=1'

Acknowledgement Of
Plans Submittal ONLY!


STEVE HODRICK Date 3.10.03

Dave Williams Date 3-10-03

All plans are copyrighted by Atlanta Plan Source, Inc. and/or Designer
Atlanta PLAN SOURCE INCORPORATED
P.O. Box 1169
Alpharetta, GA 30009
Ph: 770-664-4114
DO NOT COPY WITHOUT WRITTEN COPYRIGHT RELEASE!

Notice: Good care and effort have gone into the creation of the design and construction of these plans. However, because of the impossibility of preventing any personal and/or construction, typographical and clerical errors, the actual construction and because of the great variance in local building code requirements and other local building and weather conditions, Atlanta Plan Source, Inc. assumes no responsibility for any damages, including structural failures due to any deficiencies, omissions, or errors in the design. In any instance, the maximum liability of Atlanta Plan Source, Inc. shall be limited to the purchase price of the home plans. These home plans are designed to conform to the minimum requirements of the 2000 International Residential Code. It is recommended that your local building officials refer to the state of actual construction. Additional engineering may be required to comply with code, if applicable, by local building codes.

IF THIS STAMP IS NOT RED IT IS AN ILLEGAL SET OF PLANS
REPRODUCTION OF THESE PLANS IN ANY MEDIA IS PROHIBITED BY FEDERAL LAW. VIOLATORS ARE PURSUABLE BY FEDERAL LAW
TO STRUCTURE PER ORDERED
CALL THE DESIGNER OF RECORD
OBTAIN LEGAL COPIES OF THIS PLAN

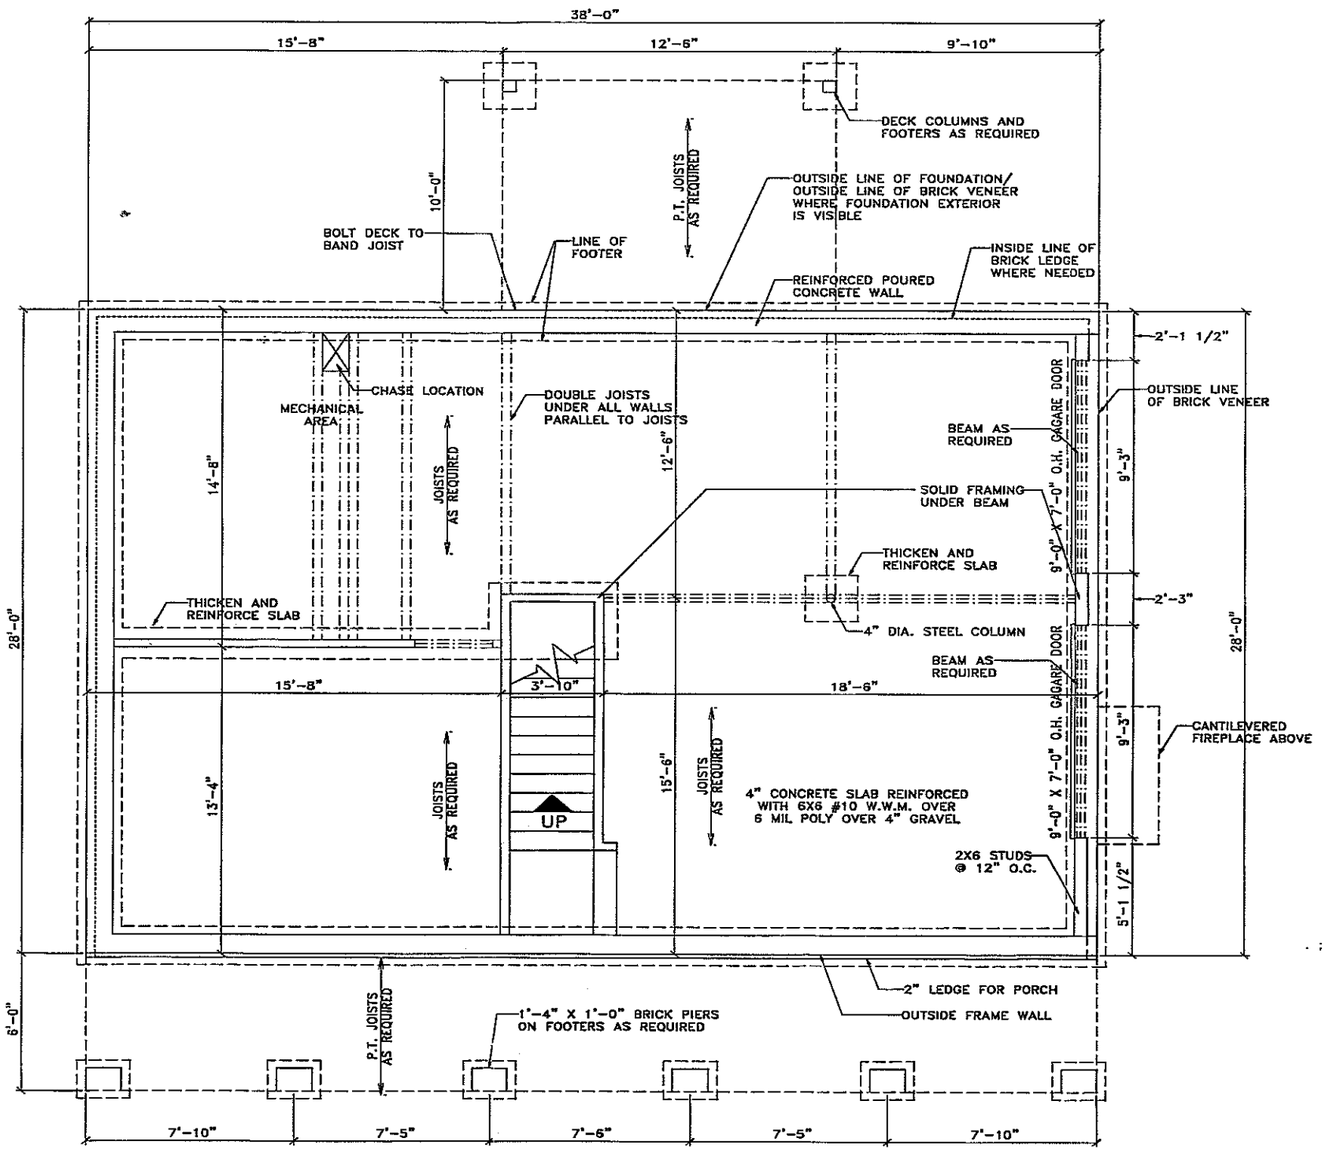

BASEMENT FOUNDATION PLAN
SCALE: 1/4"=1'

Acknowledgement Of
Plans Submittal ONLY!
STEVE HORICK Date 3-10-03
Dan Williams Date 3-10-03

IF THIS STAMP IS NOT RED ONLY IT IS AN ILLEGAL COPY

All plans are copyrighted by Atlanta Plan Source, Inc. and/or Designer
Atlanta PLAN SOURCE INCORPORATED
P.O. Box 1169
Alpharetta, GA 30009
Ph: 770-664-4114
DO NOT COPY WITHOUT WRITTEN COPYRIGHT RELEASE!
A|D B|D
Notice: Great care and effort have gone into the creation of the design and engineering of these plans. However, because of the impossibility of providing any personal and/or "on-site" consultation, supervision, and control over the actual construction and because of the great variance in local building code requirements and other local building and weather conditions, Atlanta Plan Source, Inc. assumes no responsibility for any damages, including structural failures due to any deficiencies, omissions, or errors in the design. In any instance, the maximum liability of Atlanta Plan Source, Inc. shall not exceed that amount of the blueprint price. These home plans are designed in nature. It is recommended that a professional engineer review these plans to make sure they meet your local building codes prior to the start of actual construction. Additional engineering may be required to comply with seismic, wind, or other special conditions as required by local building codes.