IREDELL COUNTY HEALTH DEPARTMENT

STATESVILLE 704-878-5305 (C1) MOORESVILLE 704-664-5281

IMPROVEMENT PERMIT / AUTHORIZATION TO CONSTRUCT / OPERATION PERMIT / EXISTING SYSTEM INSPECTION

PERMIT# 129705 PIN# 4752736833 DATE 9-9-05

OWNER OR CONTRACTOR Craig Deal PHONE: Business 704-902-4233 Home 704-873-0069

ADDRESS 3522 Taylorsville Hwy Statesville 28625

LOCATION I-77 exit 49A TR 70E TR Shiloh TL Clements on RT

SUBDIVISION _____ BLOCK / SECTION _____ LOT _____ LOT AREA 4.247 AC SITE CLASS. PS DESIGN FLOW 480gpd L.T.A.R. .3 gpd/ft²

Septic Tank: 1500 Gallons; STB 338 Date 11-12-05
Pump Tank: _____ Gallons; PT _____ Date _____
Pump Make: _____ Model _____ Serial No. _____
Nitrification Field: No Fields 1 Square Feet 1600 Linear Feet 400
No Lines 5 @ 80' Trench Width 36" Max Trench Bottom Depth 36" Gravel Depth NA

☒ New System ☐ Repair System Type: I, II, III, IV, V, VI
System Description: 25% reduction, gravity
Repair System Description: LP Panel
Maintenance Agreement Required: ☐ Yes ☒ No

☐ House/Mod. Home No. Bedrooms 4
☐ Mobile Home No. Bathrooms ____
☐ Business No. Employees ____
☒ Other Duplex


☒ Slab ☐ Crawl Space ☐ Basement w/plumbing ☐ Basement wo/plumbing

Water Supply: ☒ Individual ☐ Public ☐ Community

Comments:/Conditions:


1) Trenches shall follow the contour of the ground
2) Septic Tank 1500 gallons
3) Well drilled before permit issued

INITIAL SITE SKETCH

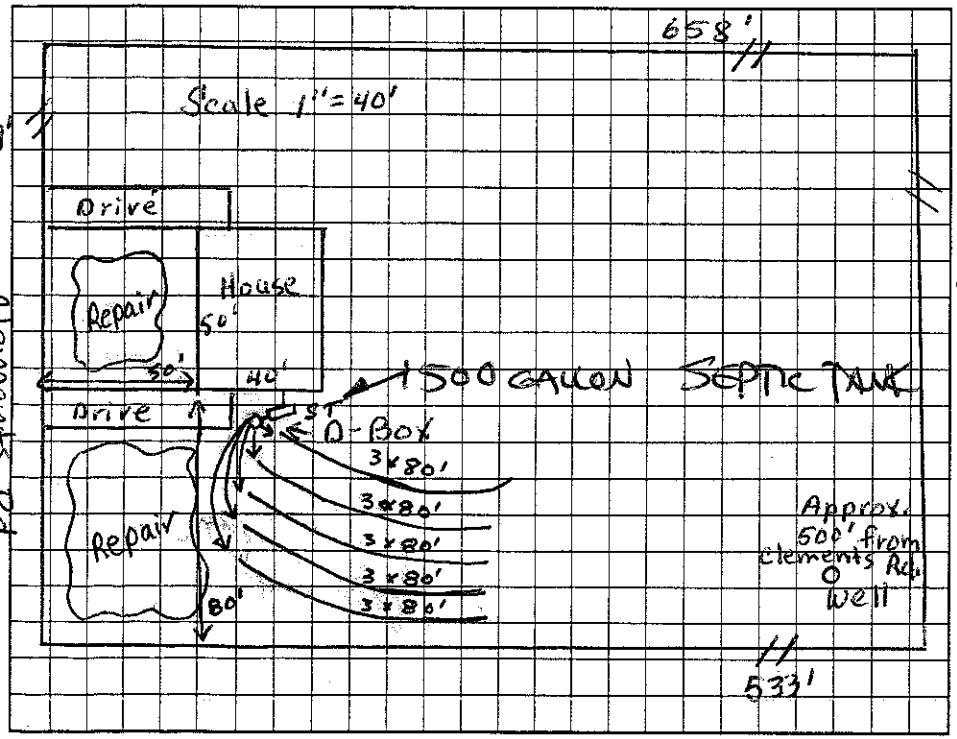

Comments:/Conditions: ① SEPTIC TANK WITH RED "Roylok" FILTER INSTALLED WITH TANK MARKER ② SYSTEM INSTALLED DURING PERIOD OF EXTREME WET SOIL CONDITIONS.

AS BUILT SKETCH

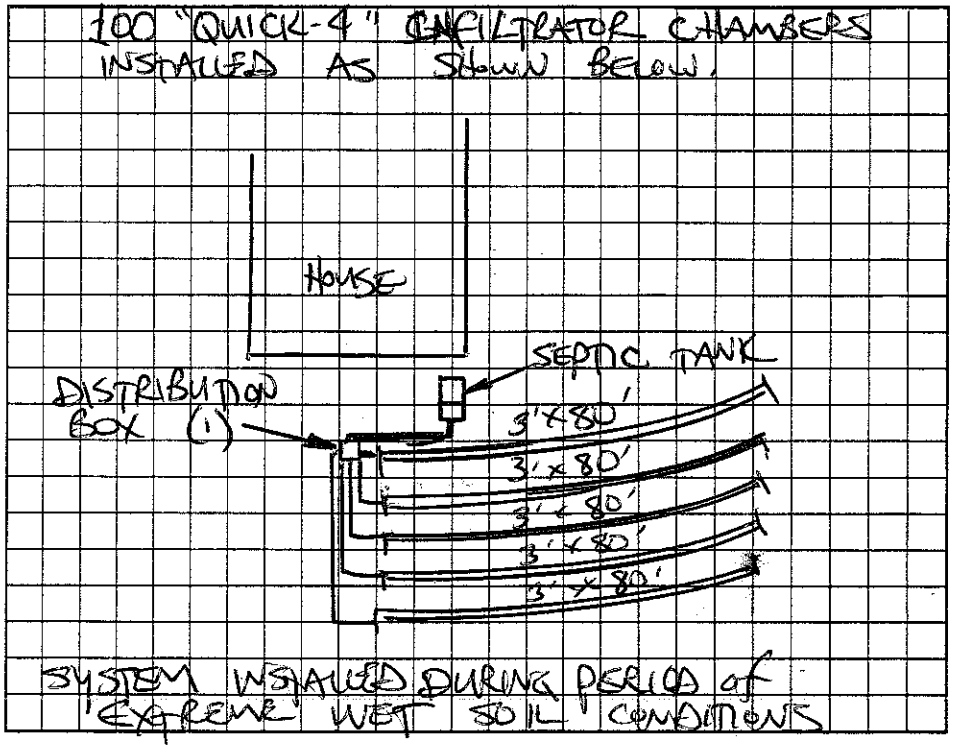

Permit can be suspended or revoked if any false information is supplied toward securing the permit/any unauthorized changes are made to the site/any unauthorized changes are made in the installation of the system. Improvement Permit with plat valid without expiration. Improvement Permit with site plan valid for sixty months. Authorization to Construct is valid for a period equal to that of Improvement Permit – not to exceed sixty months.

Signed: Craig Deal date 9-23-05 Installed by: MARY TUCKER

Improvement Permit by: Judy Melville date 9-9-05 Operation Permit by: STEVE HEDRICK date 1-17-06

Authorization to Construct by: Judy Melville date 9-9-05 Existing System Inspection by: _____ date _____

HEALTH DEPT. COPY: WHITE OWNER COPY (FINAL): YELLOW OWNER COPY (INITIAL): PINK