IREDELL COUNTY HEALTH DEPARTMENT

STATESVILLE 704-878-5305 MOORESVILLE 704-664-5281

IMPROVEMENT PERMIT / AUTHORIZATION TO CONSTRUCT / OPERATION PERMIT / EXISTING SYSTEM INSPECTION

PERMIT# 73991 PIN# 4752 83 2766 DATE 7-11-98

OWNER OR CONTRACTOR Lisa Shaffer PHONE: Business _____ Home _____

ADDRESS PO Box 663 Troutman, N.C.

LOCATION 70E TR Shiloh ch Rd To Clemments Rd 1/2 mi on Rt (160 Clements Rd)

SUBDIVISION _____ BLOCK / SECTION _____ LOT _____ LOT AREA Acre SITE CLASS. PS DESIGN FLOW 360 L.T.A.R. .13

Septic Tank: 1000 Gallons; STB 160 Date 9-6-98

Pump Tank: _____ Gallons; PT _____ Date _____

Pump Make: _____ Model _____ Serial No. _____

Nitrification Field: No Fields 1 Square Feet 900 Linear Feet 300

No Lines 5 Trench Width 36" Max Trench Bottom Depth 36" Gravel Depth N/A

☐ New System ☐ Repair System Type: I II III IV V VI

System Description: Gravity 25% Rct

Repair System Description: " " "

Maintenance Agreement Required: ☐ Yes ☐ No

☐ House/Mod. Home ☐ Mobile Home ☐ Business ☐ Other

No. Bedrooms 3 No. Bathrooms 2 No. Employees _____


☐ Slab ☐ Crawl Space ☐ Basement w/plumbing ☐ Basement wo/plumbing

Water Supply: ☐ Individual ☐ Public ☐ Community

Comments:/Conditions:

174'

INITIAL SITE SKETCH

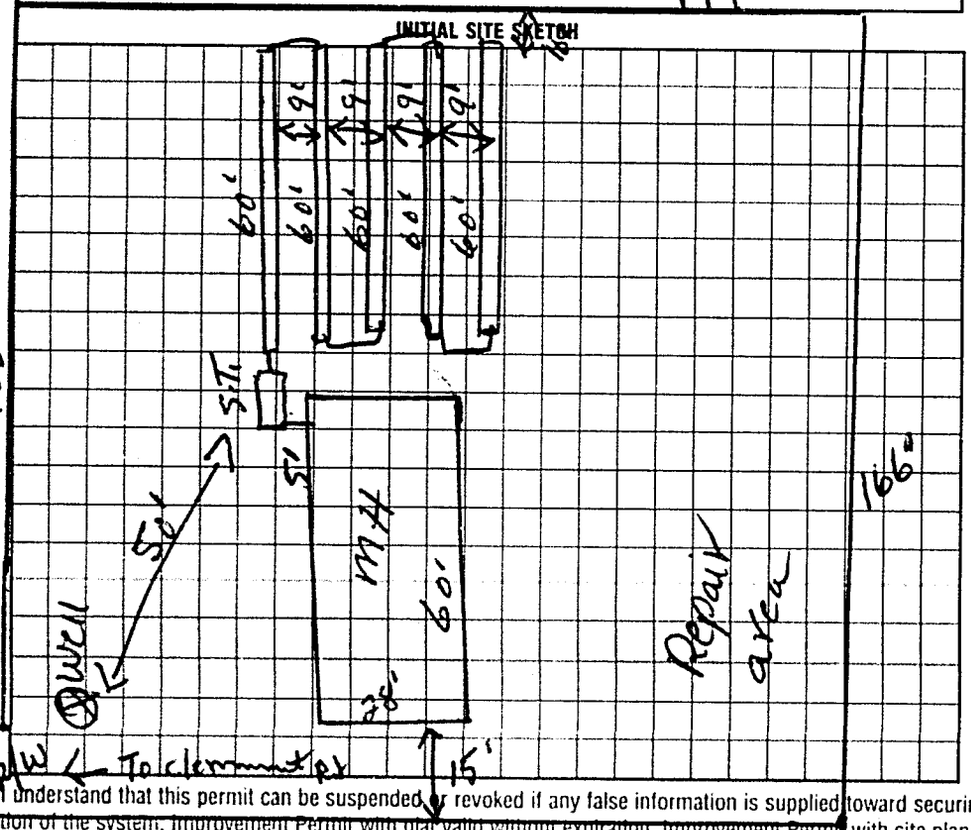

Comments:/Conditions:

AS BUILT SKETCH

Same as initial Sketch

I understand that this permit can be suspended or revoked if any false information is supplied toward securing the permit/any unauthorized changes are made to the site/any unauthorized changes are made in the installation of the system. Improvement Permit with plat valid without expiration. Improvement Permit with site plan valid for sixty months. Authorization to Construct is valid for a period equal to that of Improvement Permit – not to exceed sixty months.

Signed: Lisa Schaffer date 7-14-98 Installed by: H.B. Salmon

Improvement Permit by: F.C. Moore date 7-11-98 Operation Permit by: F.C. Moore date 12-11-98

Authorization to Construct by: F.C. Moore date 7-11-98 Existing System Inspection by: _____ date _____

HEALTH DEPT. COPY: WHITE INSPECTION COPY (FINAL): GREEN OWNER COPY (FINAL): YELLOW INSPECTION COPY (INITIAL): PINK OWNER COPY (INITIAL): GOLD

821000