IREDELL COUNTY HEALTH DEPARTMENT

STATESVILLE 704-878-5305 MOORESVILLE 704-664-5281

IMPROVEMENT PERMIT / AUTHORIZATION TO CONSTRUCT / OPERATION PERMIT / EXISTING SYSTEM INSPECTION

PERMIT# 94417 PIN# 4752 83 4552

OWNER OR CONTRACTOR EARLIE HAGER DATE 4/20/01

ADDRESS 524 COVE GAP RD. STATESVILLE NC 28625 PHONE: Business _____ Home (704) 876-3154

LOCATION HWY 70 E. (R) SHILOH CH. RD. (L) CLEMMONS RD. (R) TRENT 3RD ON (R)

SUBDIVISION LOYD ACRES BLOCK / SECTION _____ LOT 36 LOT AREA .45 Ac. SITE CLASS _____ DESIGN FLOW _____ L.T.A.R. _____

Septic Tank: EXISTING Gallons: STB _____ Date _____

Pump Tank: _____ Gallons: PT _____ Date _____

Pump Make: _____ Model _____ Serial No. _____

Nitrification Field: No Fields ____ Square Feet _____ Linear Feet _____

No Lines _____ Trench Width _____ Max Trench Bottom Depth _____ Gravel Depth _____

☐ New System ☐ Repair System Type: I. II. III. IV. V. VI

System Description: _____

Repair System Description: _____

Maintenance Agreement Required: ☐ Yes ☐ No

☐ House/Mod. Home ☑ Mobile Home ☐ Business ☐ Other _____

No. Bedrooms 2 No. Bathrooms 1 No. Employees ____

☐ Slab ☑ Crawl Space ☐ Basement w/plumbing ☐ Basement wo/plumbing


Water Supply: ☐ Individual ☐ Public ☐ Community SHARED

Comments:/Conditions:

Comments:/Conditions: (1) PUMP SEPTIC TANK EVERY 3-5 YRS.

INITIAL SITE SKETCH

AS BUILT SKETCH

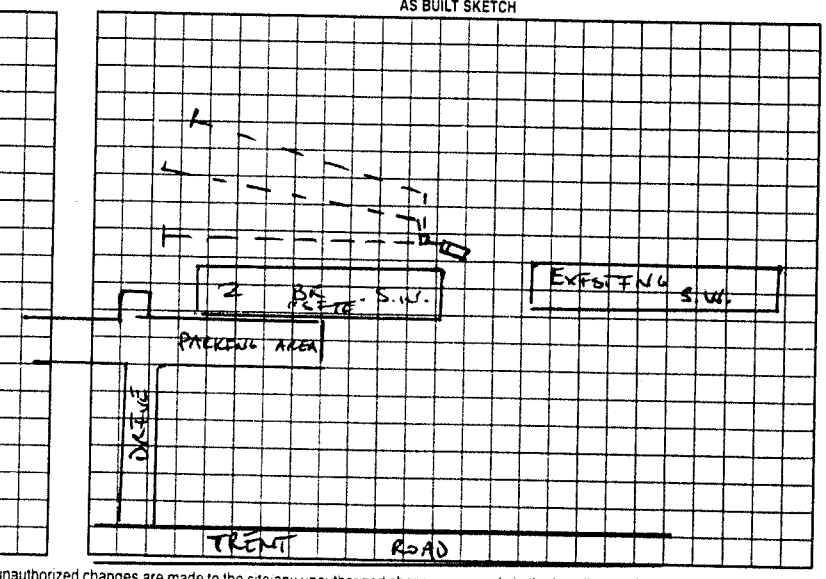

Permit can be suspended or revoked if any false information is supplied toward securing the permit/any unauthorized changes are made to the site/any unauthorized changes are made in the installation of the system. Improvement Permit with plat valid without expiration. Improvement Permit with site plan valid for sixty months. Authorization to Construct is valid for a period equal to that of Improvement Permit – not to exceed sixty months.

Signed: _____ date _____ Installed by: _____

Improvement Permit by: _____ date _____ Operation Permit by: _____ date _____

Authorization to Construct by: _____ date _____ Existing System Inspection by: Duane Shinn date 4/20/01

HEALTH DEPT. COPY WHITE OWNER COPY (FINAL) YELLOW OWNER COPY (INITIAL) PINK