IREDELL COUNTY HEALTH DEPARTMENT

Mooresville Phone TR 3-7271

PERMIT TO INSTALL SEPTIC TANK

Mooresville Phone NO 3-1271

Permit NO. 298 Permit Date 9-1-1970

Owner Ray Love Address Rt. 7 Statesville

Installed By Lackey Brothers Address Stony Point, N. C

Location of Property Shiloh Church Rd (2318) off U.S 70

1st hardtop road to left after 3rd Creek (2358)


One mile, House on right

Tank		Capacity		Length of Lines		Fixtures	
Block	( )	1000	(✓)	225'	(✓)	No. of Baths	(1)
Precast	(✓)	1250	( )	250'	( )	Dishwasher	( )
		1500	( )	Other		Garbage Grdr.	( )
		Other				Other	

NOTIFY HEALTH DEPARTMENT AT LEAST EIGHT HOURS BEFORE TANK IS TO BE INSPECTED.

Final Inspection 9-1-1970 Approved (✓) Disapproved ( )

Remarks

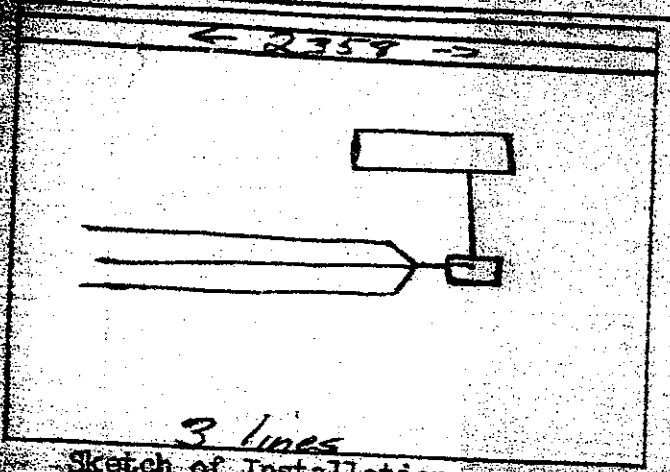

3 lines

Sketch of Installation

Carson S Hall

Sanitarian