Statesville Clayton Homes - Contact Vinnie Nathaniel (704) 873-2547

IREDELL COUNTY HEALTH DEPARTMENT

STATESVILLE 704-878-5305 (ad) (ad) MOORESVILLE 704-664-5281

IMPROVEMENT PERMIT / AUTHORIZATION TO CONSTRUCT / OPERATION PERMIT / EXISTING SYSTEM INSPECTION

PERMIT # 158253 PIN # 4752-83-8685 DATE 10/8/09

OWNER or APPLICANT Clayton Mobile Homes #72 PHONE: Business (704) 873-2547 Home: Rivera (704) 450-0379

OWNER or APPLICANT ADDRESS Kings Ferry Rd Statesville

LOCATION / DIRECTIONS I-77 South TL Amity Hill Rd (exit 45) TL Shiloh Church Rd TR Clements TR 1st TR Vinson Rd 2nd on Right

SUBDIVISION Loyd Acres - BLOCK / SECTION LOT # 31 LOT AREA 0.5Ac DESIGN FLOW L.T.A.R.

Kim Rourke Kristin Christy


Septic Tank	1000	Gallons: STB	1000-1000	Date	5-12-08	☐ New System	Repair ☒ Expansion System* Type I ☐ II ☐ III ☐ IV ☐ V ☐ VI
Pump Tank		Gallons: P T		Date		System Description:	GRAV. CONV. Bed
Pump Make		Model		Serial #		Repair System Description:	EXISTING SYSTEM
Nitrification Field	No Fields 1	No Lines	Linear Feet	EXISTING		Maintenance Agreement Required	☐ YES ☒ NO
Trench Width		Max. Trench Bottom Depth		Gravel Depth		☒ GRAVITY	☐ PRESSURE

☒ Residence No. Bedrooms 3
☐ Business No. Persons 2
☐ Other No. Employees
☐ Slab ☒ Crawl Space
☐ Basement w/plumbing ☐ Basement w/o plumbing

Water Supply: ☒ Private ☐ Public ☐ Community

Comments / Conditions: (Lot Recorded 1970) *TANK not basement only MUST Pump out Existing Septic Tank. Crush Existing Septic Tanks Try at least 5' from Porch/Deck. With new 1000gal Septic Tank (Meets Current Rules)

INITIAL SITE SKETCH

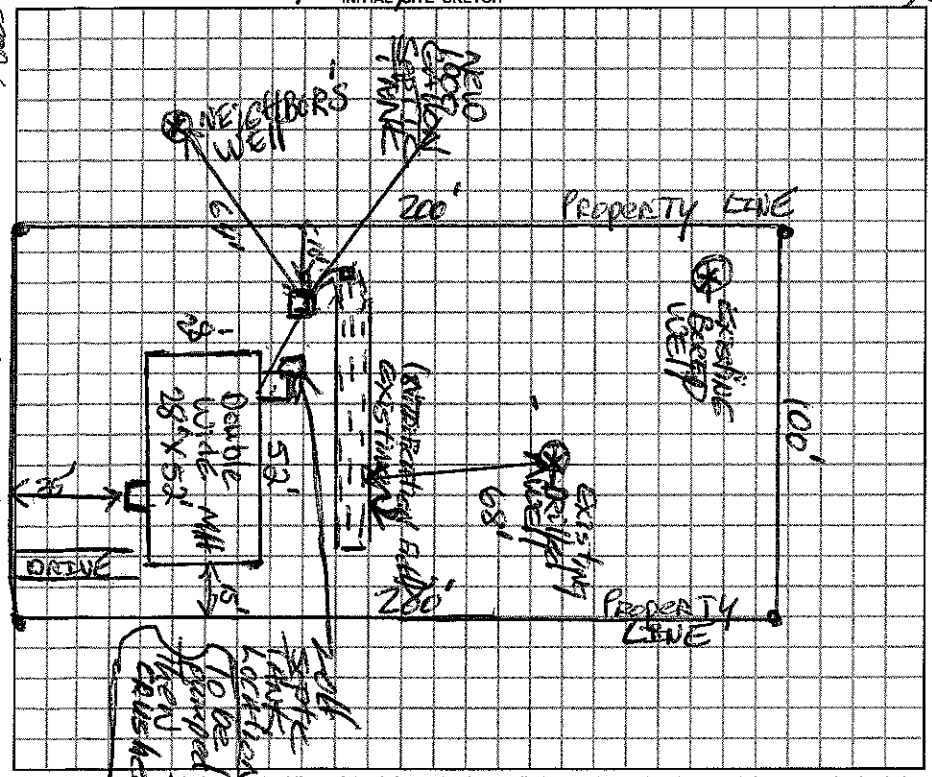

Comments / Conditions: Stay At least 6' from Neighbors WELL Must Tie in to Existing drain fields Distribution Box and/or Set new Distribution Box for existing Homes.

AS BUILT SKETCH

Complete System to be in place before final approval can be Given.

ST has filter - pol-flo

Installed as drawn.

Permit can be suspended or revoked if any false information is supplied toward securing the permit / any unauthorized changes are made to the site / any unauthorized changes are made in the installation of the system.

☐ IMPROVEMENT PERMIT w / plat valid without expiration. ☒ IMPROVEMENT PERMIT w / site plan valid for 60 mos. ☒ AUTHORIZATION TO CONSTRUCT valid for period equal to IMPROVEMENT PERMIT-not to exceed 60 mo.

Owner / Applicant Signature: [signature] Date 10/12/09

Improvement Permit by: [signature] Date 10/8/09

Authorization to Construct by: [signature] Date 10/8/09

Installed by: Ground breaker

Operation Permit by: [signature], R.S. Date: 26 Oct 09

Existing System Inspected by: Date:

YOU SHOULD CONTACT A LOCATOR SERVICE PRIOR TO ANY EXCAVATION.

WHITE COPY Environmental Health YELLOW COPY (Final) Owner / Applicant PINK COPY (Initial) Owner / Applicant