IREDELL COUNTY HEALTH DEPARTMENT

STATESVILLE 704-878-5305 (ad) MOORESVILLE 704-664-5281 (ad)

IMPROVEMENT PERMIT / AUTHORIZATION TO CONSTRUCT / OPERATION PERMIT / EXISTING SYSTEM INSPECTION

PERMIT # 156583 PIN # 4752-84-2090 DATE 5-18-09

OWNER or APPLICANT Sypras Sisoukrath (Freedom Homes) PHONE: Business 704 746 4778 Home:

OWNER or APPLICANT ADDRESS 162 Clements Rd.

LOCATION / DIRECTIONS Hwy 115/21 to Amity Hill Road (L), then turn left on Shiloh Road then (R) on Clements, lot on (R)

SUBDIVISION n/a BLOCK / SECTION LOT # 1 LOT AREA 1.019 DESIGN FLOW 480 L.T.A.R. .25

Septic Tank 1000 Gallons: STB 1460 Date 11-18-05

Pump Tank Gallons: PT Date

Pump Make Model Serial #

Nitrification Field No Fields 1 No Lines Linear Feet 480

Trench Width 36" Max. Trench Bottom Depth 30" Gravel Depth n/a

☒ New System ☐ Repair ☐ Expansion System Type I (II) III IV V VI

System Description: 25% Reduction Gravity

Repair System Description: 25% Reduction Gravity

Maintenance Agreement Required ☐ YES ☒ NO

☒ GRAVITY ☐ PRESSURE

☒ Residence No. Bedrooms 4 ☐ Business No. Persons ☐ Other No. Employees ☐ Slab ☒ Crawl Space ☐ Basement w/plumbing ☐ Basement w/o plumbing


Water Supply: ☒ Private ☐ Public ☐ Community

Comments / Conditions


Comments / Conditions

2nd Lot Feb

INITIAL SITE SKETCH

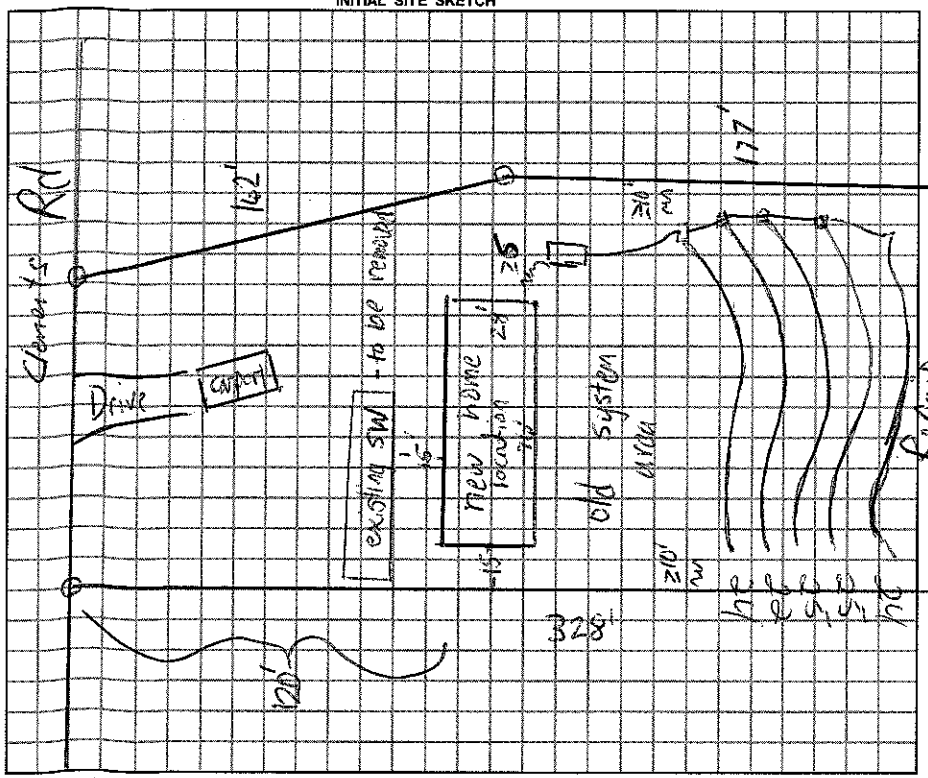

AS BUILT SKETCH

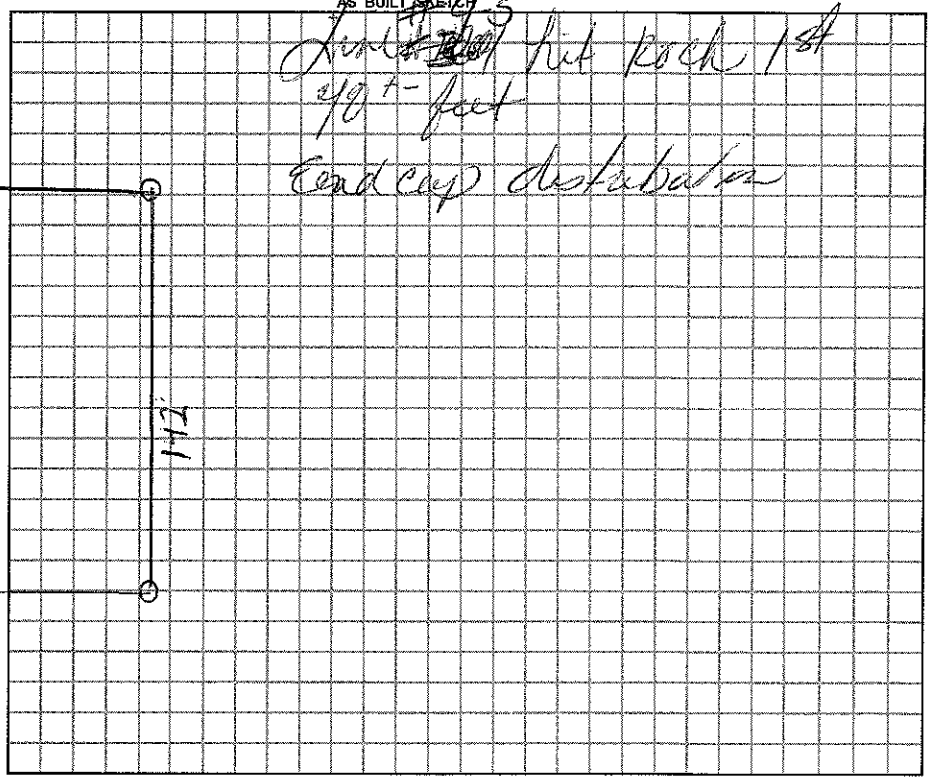

Permit can be suspended or revoked if any false information is supplied toward securing the permit / any unauthorized changes are made to the site / any unauthorized changes are made in the installation of the system.

☐ *IMPROVEMENT PERMIT w / plat valid without expiration.* ☒ *IMPROVEMENT PERMIT w / site plan valid for 60 mos.* ☒ *AUTHORIZATION TO CONSTRUCT valid for period equal to IMPROVEMENT PERMIT-not to exceed 60 mo.*

Owner / Applicant Signature: Date 5-27-09

Improvement Permit by: Date 5-18-09

Authorization to Construct by: Date 5-18-09

Installed by: H-J Backhoe

Operation Permit by: Date: 6-22-09

Existing System Inspected by: Date:

YOU SHOULD CONTACT A LOCATOR SERVICE PRIOR TO ANY EXCAVATION.

WHITE COPY Environmental Health YELLOW COPY (Final) Owner / Applicant PINK COPY (Initial) Owner / Applicant