PIN# 4752-84-5499

IREDELL COUNTY HEALTH DEPARTMENT

STATESVILLE 704-878-5305 MOORESVILLE 704-664-5281

IMPROVEMENT PERMIT / CERTIFICATE OF COMPLETION / OPERATION PERMIT / EXISTING SYSTEM INSPECTION

PROPERTY DESCRIPTION NO. 19721 DATE 11/22/94 TAX MAP NO. 4J 1A 1 Watershed: ☐ Yes ☑ No

OWNER OR CONTRACTOR Jeffrey Parker PHONE: Business _____ Home 324-5175

ADDRESS Rt 4 Box 681 Hickory, NC 28602

LOCATION Sherrill's Rd ~5 miles on (R) last house on (L)

SUBDIVISION Creekview BLOCK / SECTION 1 LOT 1 LOT AREA ~30,000 FT² SITE CLASS. P DESIGN FLOW 360 L.T.A.R. .3

Septic Tank: 1000 Gallons; STB 781 Date 8/14/94

Pump Tank: _____ Gallons; PT _____ Date _____

Pump Make: _____ Model _____ Serial No. _____

Nitrification Field: No Fields 1 Square Feet 1200 Linear Feet 400

No Lines 4 Trench Width 36" Max Trench Bottom Depth 36" Gravel Depth 12"

☑ New System ☐ Repair System Type: I, (II), III, IV, V, VI

System Description: CONV - DIST BOX

Repair System Description: SAME

Maintenance Agreement Required: ☐ Yes ☑ No

☐ House/Mod. Home No. Bedrooms 3

☑ Mobile Home No. Bathrooms 2

☐ Business No. Employees _____

☐ Other _____

☐ Slab ☑ Crawl Space ☐ Basement w/plumbing ☐ Basement wo/plumbing


Water Supply:
☐ Individual
☐ Community
☐ Public

Comments:

Lines on slope contour.

Comments:

INITIAL SITE SKETCH

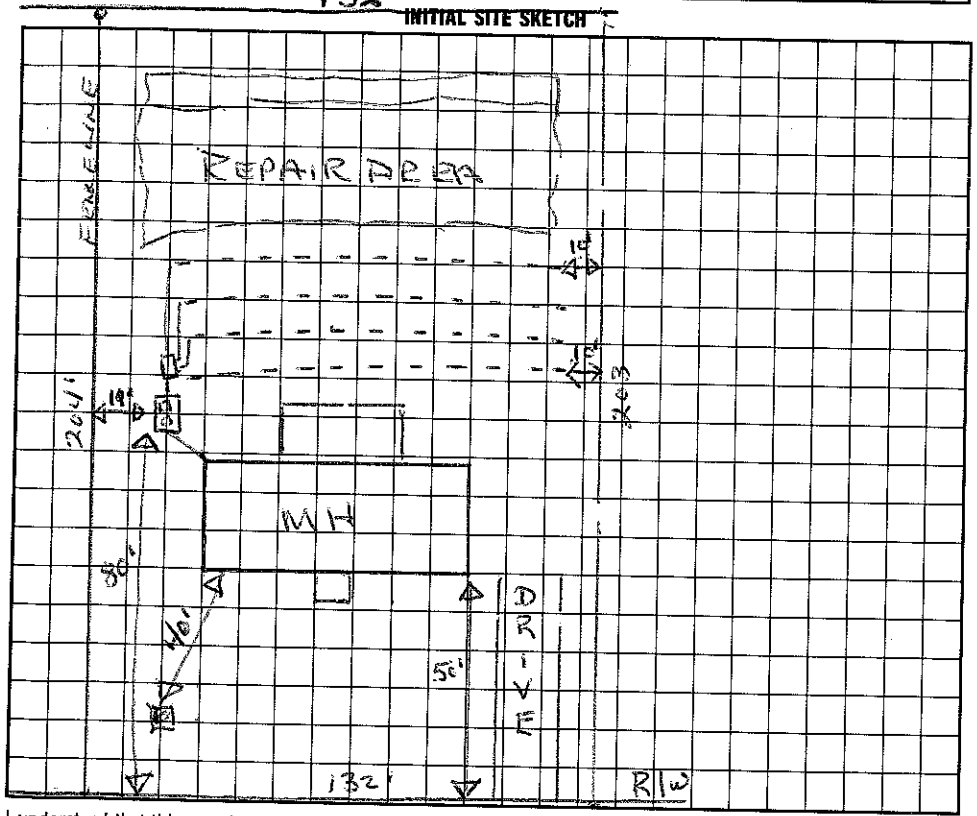

AS BUILT SKETCH

I understand that this permit can be suspended or revoked if any false information is supplied toward securing the permit/any unauthorized changes are made to the site/any unauthorized changes are made in the installation of the system. Improvement Permit is valid for 60 months from date of issuance.

Signed: Jeffrey Parker

Improvement Permit by: Wesley Sparks RS. date 11/22/94

Existing System Inspection by: _____ date _____

Installed by: Dan Heatherman

Certificate of Completion by: Wesley Sparks RS. date 12/19/94

Operation Permit by: _____ date _____

HEALTH DEPT. COPY: WHITE INSPECTION COPY (FINAL): GREEN OWNER COPY (FINAL): YELLOW INSPECTION COPY (INITIAL): PINK OWNER COPY (INITIAL): GOLD