IREDELL COUNTY HEALTH DEPARTMENT

STATESVILLE 704-878-5305 MOORESVILLE 704-664-5281

IMPROVEMENT PERMIT / CERTIFICATE OF COMPLETION / OPERATION PERMIT / EXISTING SYSTEM INSPECTION

PROPERTY DESCRIPTION NO. 1956 DATE 10/19/94 TAX MAP NO. 4J-1-1A-5 Watershed: ☐ Yes ☒ No

OWNER OR CONTRACTOR Robert Van Pelt PHONE: Business PIN# 4752-84-5909 Home 663-0978

ADDRESS PO Box 158 Mt Mourne, NC.

LOCATION Shumaville Rd, 2 miles past store on (R)

SUBDIVISION Crestview BLOCK / SECTION 1 LOT 6 LOT AREA ~.54 SITE CLASS P DESIGN FLOW 240 L.T.A.R. .3

Septic Tank: 1000 Gallons; STB 821 Mull Date 9-29-94

Pump Tank: ____ Gallons; PT ____ Date ____

Pump Make: ____ Model ____ Serial No. ____

Nitrification Field: No Fields 1 Square Feet 800 Linear Feet 266

No Lines 4 Trench Width 3' Max Trench Bottom Depth 32" Gravel Depth 12"

☐ New System ☐ Repair System Type: I, ☒ II, III, IV, V, VI

System Description: DROP BOX - CONV.

Repair System Description: GRAVITY - PANEL

Maintenance Agreement Required: ☐ Yes ☒ No

☐ House/Mod. Home ☒ Mobile Home ☐ Business ☐ Other

No. Bedrooms 2 No. Bathrooms 2 No. Employees ____


☐ Slab ☒ Crawl Space ☐ Basement w/plumbing ☐ Basement wo/plumbing

Water Supply: ☒ Individual ☐ Community ☐ Public


Comments: Follow contours as shown - TIGHT No room for mistakes

Comments: Mobile home not set up / WELL NOT installed as of 11/4/94

INITIAL SITE SKETCH

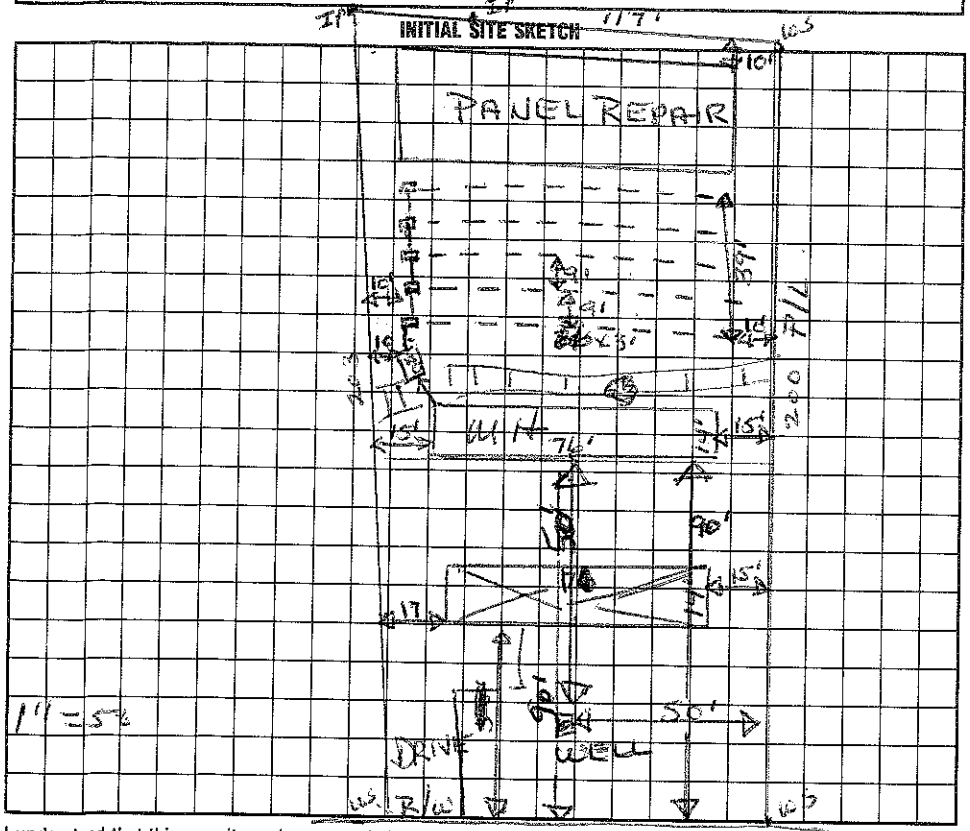

AS BUILT SKETCH

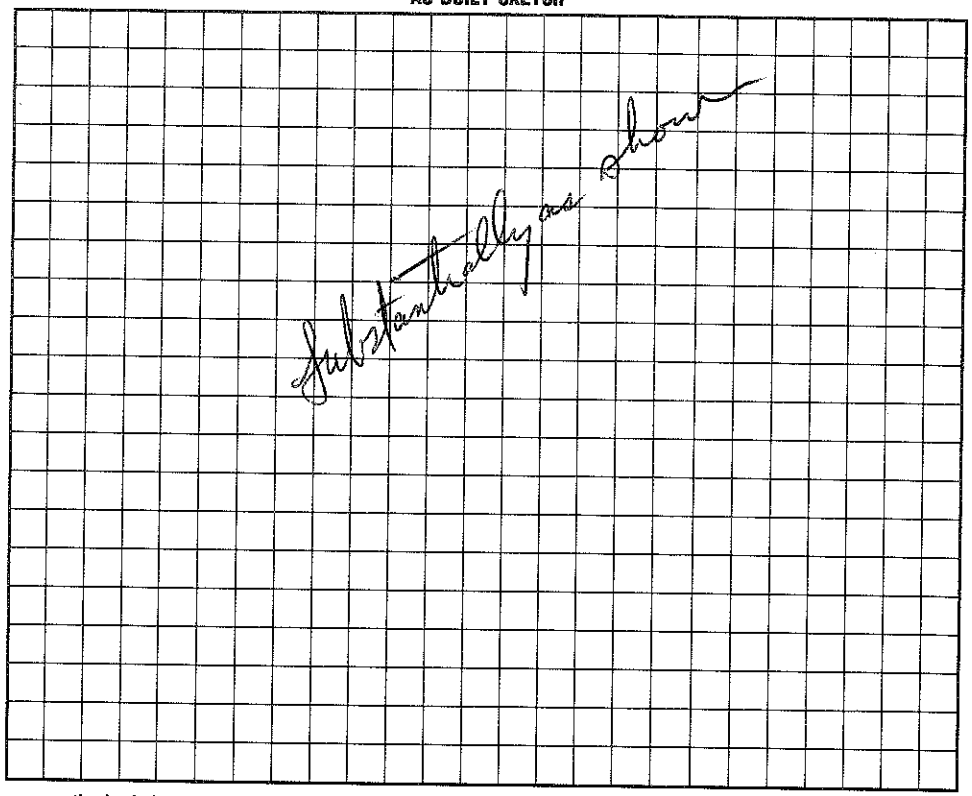

I understand that this permit can be suspended or revoked if any false information is supplied toward securing the permit/any unauthorized changes are made to the site/any unauthorized changes are made in the installation of the system. Improvement Permit is valid for 60 months from date of issuance.

Signed: X Mark Bozel

Improvement Permit by: Wesley Sparks RS. date 10/19/94

Existing System Inspection by: ____ date ____

Installed by: Gary Miller / Gary M Enterprises

Certificate of Completion by: Jamie Hinson RS date 11/4/94

Operation Permit by: ____ date ____

HEALTH DEPT. COPY: WHITE INSPECTION COPY (FINAL): GREEN OWNER COPY (FINAL): YELLOW INSPECTION COPY (INITIAL): PINK OWNER COPY (INITIAL): GOLD