# IREDELL COUNTY HEALTH DEPARTMENT

Statesville Office (704) 878-5305 Mooresville Office (704) 660-3625 PERMIT # 180924 BF

## IMPROVEMENT PERMIT / AUTHORIZATION TO CONSTRUCT / OPERATION PERMIT / EXISTING SYSTEM

PIN # 4752868164

APPLICANT: Allen Johnson APPLICANT ADDRESS: 1052 Davis St.

SITE ADDRESS: 192 Crestview Acres Rd. PHONE: 704-326-6736 ALT. PHONE: N/A

SITE DIRECTIONS: Hwy 21S TL Amity Hill Rd. TL Sh/dr Rd. TR Clontes Rd. TL Crestview Acres.

SUBDIVISION: Crestview SECTION: N/A LOT # 32 LOT AREA: 5.1 acres DESIGN FLOW: 480gpd L.T.A.R.: 0.2

| | | | | | | | | | |
|---|---|---|---|---|---|---|---|---|---|
| Septic Tank | 1000 (gal) | STB | 796-1000 | Date | 11-4-13 | ☑ New System | ☐ Repair | ☐ Expansion | System Type: I II ☒ III IV V VI |
| Pump Tank | (gal) | PT | | Date | | System Description: | 25% Reduction | | |
| Pump Make | | Model | | Serial # | | Repair System Description: | Drip | | |
| # Nitrification Fields | 1 | # Lines | 3 | Linear Ft: | 600 | Maintenance Agreement Required: | ☐ YES | ☑ NO | |
| Trench Width | 36" | Max. Trench Bottom Depth | 36" | Gravel Depth | N/A | ☑ GRAVITY | ☐ PRESSURE | | |


☑ Residence ☐ Business ☐ Other ☐ Slab ☐ Basement w/plumbing

No. Bedrooms 4 No. Persons No. Employees ☑ Crawl Space ☐ Basement w/o plumbing


Water Supply: ☑ Private ☐ Public ☐ Community

Comments / Conditions: IMPROVEMENTS ONLY & Submit floor plan prior to issuance of CA. Install a 25% Reduction system on contour with serial distribution.

INITIAL SITE SKETCH

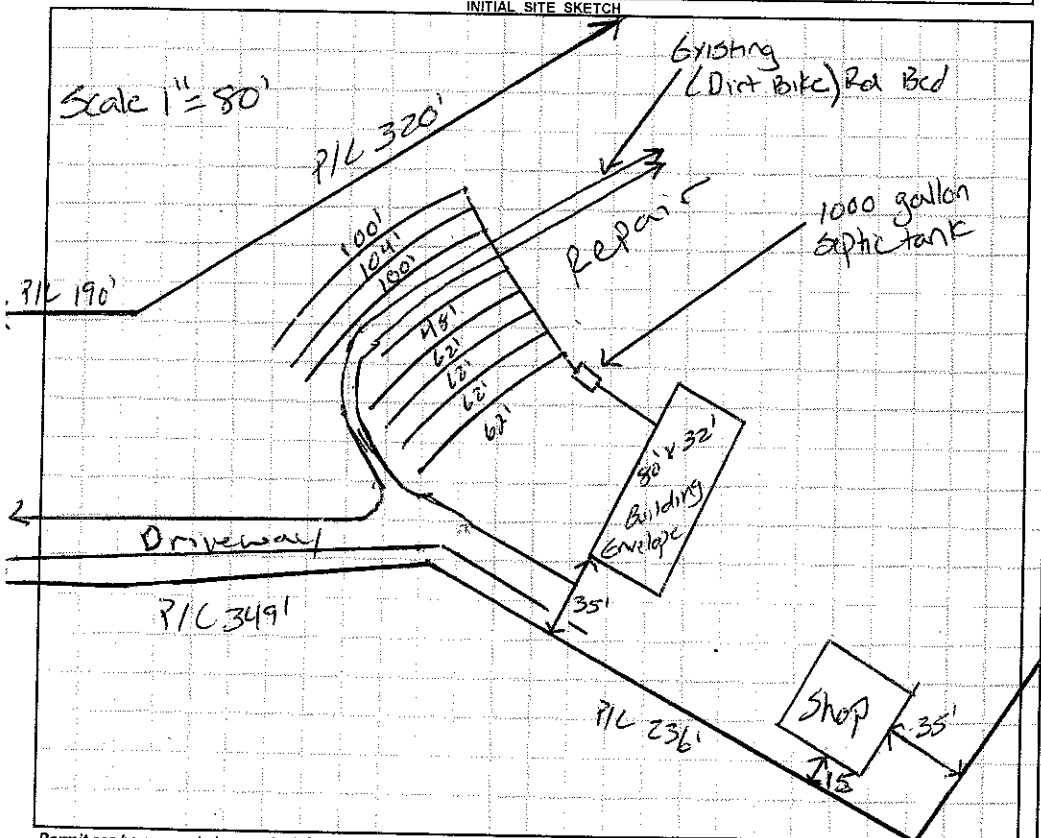


AS BUILT SKETCH

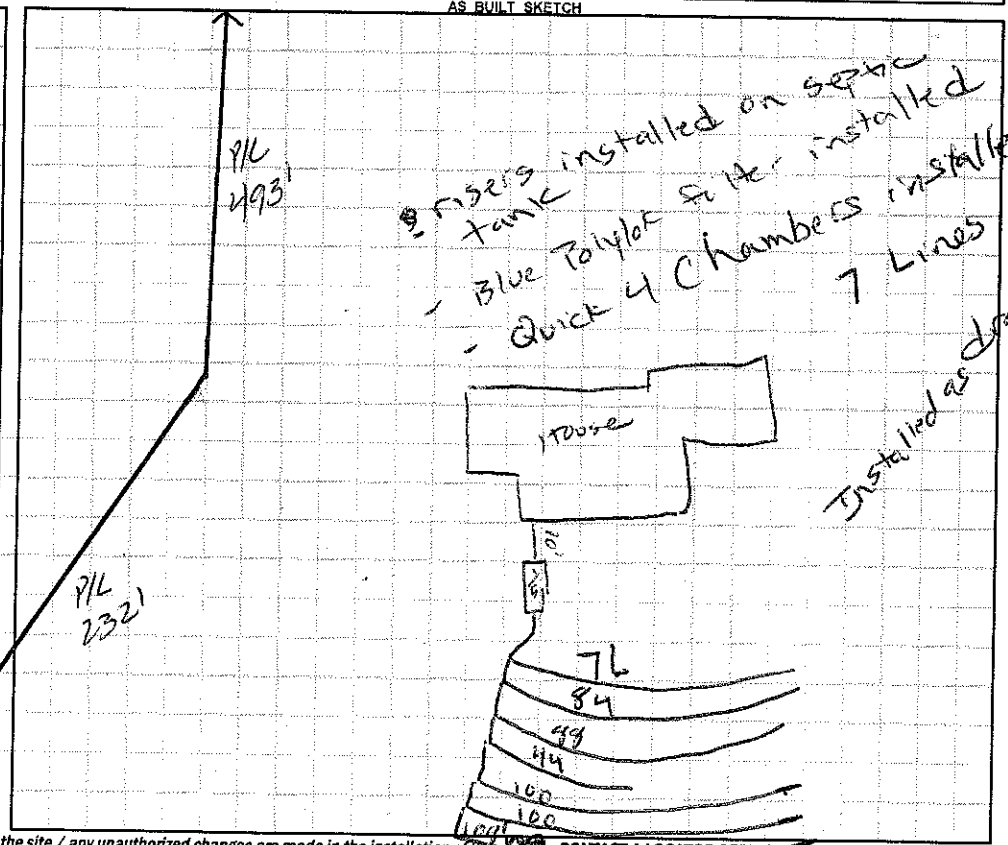


*Permit can be suspended or revoked if any false information is supplied toward securing the permit / any unauthorized changes are made to the site / any unauthorized changes are made in the installation of the system.* **CONTACT A LOCATOR SERVICE PRIOR TO ANY EXCAVATION**

☐ **IMPROVEMENT PERMIT** *with plat valid without expiration.* ☑ **IMPROVEMENT PERMIT** *with site plan valid for 60 mos.* ☑ **AUTHORIZATION TO CONSTRUCT** *valid for period equal to IMPROVEMENT PERMIT--not to exceed 60 mo.*

Owner / Applicant Signature: Amy Johnston Date: 12-18-13 Installed by: BW Christenbury

IMPROVEMENT PERMIT by: Justin Henderson Date: 10-10-13 OPERATION PERMIT by: Justin Henderson Date: 4-24-14

AUTHORIZATION TO CONSTRUCT by: Justin Henderson Date: 12-11-13 Existing System Inspected by: Date:

Health Dept. Copy - WHITE Applicant (Final Approval) - YELLOW Applicant (Conditional Approval) - PINK