IREDELL COUNTY HEALTH DEPARTMENT

STATESVILLE 704-878-5305 MOORESVILLE 704-664-5281

IMPROVEMENT PERMIT / AUTHORIZATION TO CONSTRUCT / OPERATION PERMIT / EXISTING SYSTEM INSPECTION

PERMIT# 83532 PIN# 4752931479 DATE 9-8-99

OWNER OR CONTRACTOR Troy Locklear PHONE: Business Home 872-5641

ADDRESS 130 Henderson Dr. Statesville, N.C.

LOCATION 70 E TR Shiloh Ch TL Clemments TR Trent on Rt.

SUBDIVISION Lloyd Acres BLOCK / SECTION LOT 19 LOT AREA 1.0 acre SITE CLASS P5 DESIGN FLOW 360 L.T.A.R. .13

Septic Tank: 1000 Gallons; STB 825 Date 8-2-99
Pump Tank: Gallons; PT Date
Pump Make: Model Serial No.
Nitrification Field: No Fields 1 Square Feet 900 Linear Feet 300
No Lines 4 Trench Width 36" Max Trench Bottom Depth 36" Gravel Depth

☒ New System ☐ Repair System Type: I. II. III. IV. V. VI
System Description: Gravity 25% Red.
Repair System Description: " 50% Red.
Maintenance Agreement Required: ☐ Yes ☒ No

☒ House/Mod. Home ☐ Mobile Home ☐ Business ☐ Other
No. Bedrooms 3 No. Bathrooms 2 No. Employees


☐ Slab ☒ Crawl Space ☐ Basement w/plumbing ☐ Basement wo/plumbing

Water Supply: ☒ Individual ☐ Public ☐ Community

Comments/Conditions:

Comments/Conditions

INITIAL SITE SKETCH

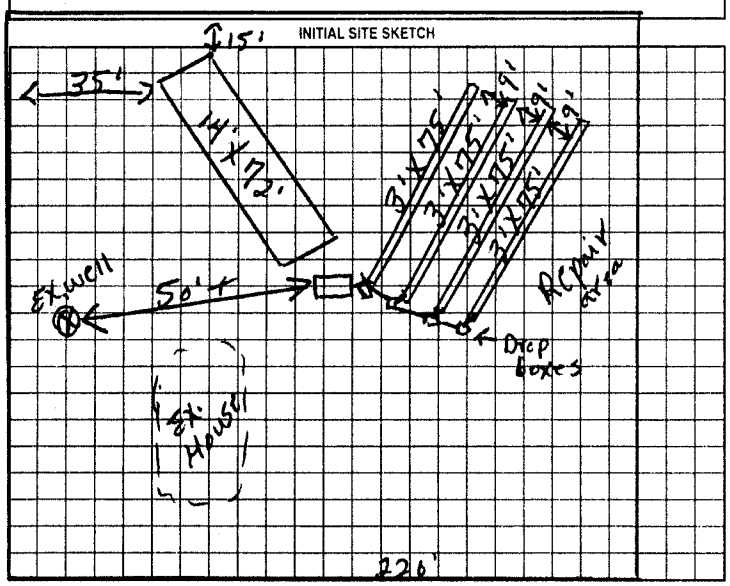

AS BUILT SKETCH

Same as initial Sketch

Permit can be suspended or revoked if any false information is supplied toward securing the permit/any unauthorized changes are made to the site/any unauthorized changes are made in the installation of the system. Improvement Permit with plat valid without expiration. Improvement Permit with site plan valid for sixty months. Authorization to Construct is valid for a period equal to that of Improvement Permit – not to exceed sixty months.

Signed: Troy Locklear date Installed by: Rowan ST Co.

Improvement Permit by: J. C. Moore date 9-8-99 Operation Permit by: J. C. Moore date 9-23-99

Authorization to Construct by: J. C. Moore date 9-8-99 Existing System Inspection by: date

HEALTH DEPT. COPY WHITE OWNER COPY (FINAL) YELLOW OWNER COPY (INITIAL) PINK