IREDELL COUNTY HEALTH DEPARTMENT

STATESVILLE 704-878-5305 MOORESVILLE 704-664-5281

IMPROVEMENT PERMIT / CERTIFICATE OF COMPLETION / OPERATION PERMIT / EXISTING SYSTEM INSPECTION

PROPERTY DESCRIPTION NO. 25189 DATE 10-17-96 TAX MAP NO. 5E-1-A-17 Watershed: ☐ Yes ☑ No

OWNER OR CONTRACTOR William Robert Estes PHONE: Business _____ Home 876-3058

ADDRESS 133 Jane Sowers Rd Statesville

LOCATION NOE TR Shiloh Rd IL Clemmont IR ~~SR~~ Trent TL Vinson 1/4mi Rt.

SUBDIVISION Lloyds Acres BLOCK / SECTION _____ LOT 17 LOT AREA 100'x200' SITE CLASS. PS DESIGN FLOW 360 L.T.A.R. .33

Septic Tank: 1000 Gallons; STB 825 Date 5-11-97

Pump Tank: _____ Gallons; PT _____ Date _____

Pump Make: _____ Model _____ Serial No. _____

Nitrification Field: No Fields 4 Square Feet 360 Linear Feet 1080

No Lines 4 Trench Width 36" Max Trench Bottom Depth 36" Gravel Depth 12"

☑ New System ☐ Repair System Type: I, II, III, IV, V, VI

System Description: Conv. Gravity

Repair System Description: Gravity Panels

Maintenance Agreement Required: ☐ Yes ☐ No

☐ House/Mod. Home ☑ Mobile Home ☐ Business ☐ Other

No. Bedrooms 3 No. Bathrooms 2 No. Employees ____


☐ Slab ☑ Crawl Space ☐ Basement w/plumbing ☐ Basement wo/plumbing

Water Supply: ☑ Individual ☐ Community ☐ Public Well Next door at Lot 18


Comments:

Comments:

INITIAL SITE SKETCH

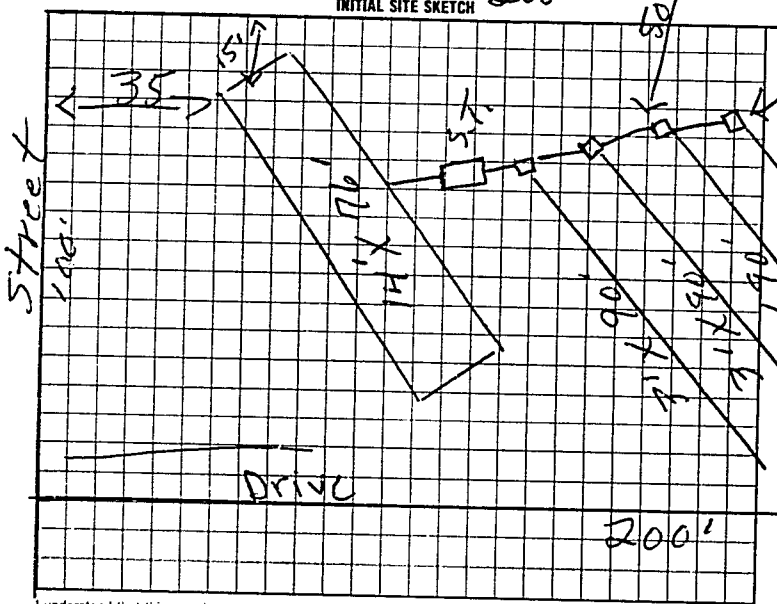

AS BUILT SKETCH

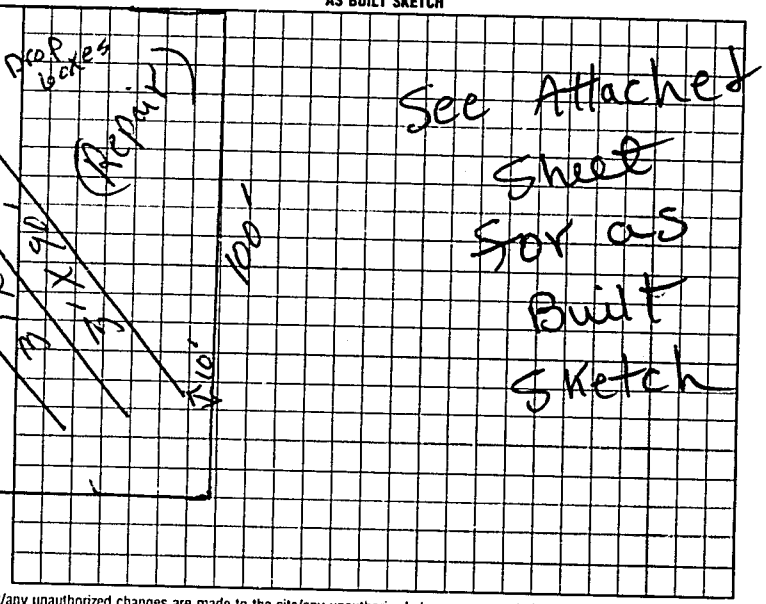

See Attached Sheet for as Built Sketch

I understand that this permit can be suspended or revoked if any false information is supplied toward securing the permit/any unauthorized changes are made to the site/any unauthorized changes are made in the installation of the system.

Signed: William R Estes Installed by: Barry Sigmon

Improvement Permit by: L.C. moore date 10-17-96 Certificate of Completion by: _____ date _____

Authorization L.C. moore date 10-17-96 Operation Permit by L.C. moore date 7-18-97

COUNTY DEPT. COPY: WHITE INSPECTION COPY (FINAL): GREEN OWNER COPY (FINAL): YELLOW INSPECTION COPY (INITIAL): PINK OWNER COPY (INITIAL): GOLD

Authorization to Const Expires 60 mos from issue

9 5 5 0 0 0