IREDELL COUNTY HEALTH DEPARTMENT

STATESVILLE 704-878-5305 MOORESVILLE 704-664-5281

IMPROVEMENT PERMIT / CERTIFICATE OF COMPLETION / OPERATION PERMIT / EXISTING SYSTEM INSPECTION

PROPERTY DESCRIPTION NO. 6562 DATE 6-29-93

OWNER OR CONTRACTOR David Crooks PHONE: Business Home 873-0560

ADDRESS 146 Cara Jane TAX MAP NO. 5E-1-A-15

LOCATION 70E TR Shiloh Ch Rd TL Clemmons TR Trent TL Vinson Hwy

SUBDIVISION Fleetwood BLOCK / SECTION A LOT 15 LOT AREA 121 X 200 SITE CLASS. PS L.T.A.R. .49 gal/sq ft/day

1000

Water Supply: ☒ Individual ☐ Community ☐ Public

Septic Tank: ~~1000~~ Gallons; STB 358 Date 4-20-93

Pump Tank: ____ Gallons; PT ____ Date ____

Nitrification Field: No Fields 1 Square Feet 900 Linear Feet 300

No Lines 3 Trench Width 36 Trench Depth 36 Gravel Depth 12

☒ New System ☐ Repair System Type: I. II. III. IV. V. VI

System Description: Conv. Gravity

Repair System Description Conv. Pump

Maintenance Agreement Required: ☐ Yes ☐ No

~~☐~~ House/Mod. Home ☒ Mobile Home ☐ Business ☐ Other

No. Bedrooms 3 No. Bathrooms 2 No. Employees ____

☐ Slab ☒ Crawl Space ☐ Basement w/plumbing

Garbage Disposal: ☒ Yes ☐ No

Auto. Dishwasher: ☒ Yes ☐ No


Auto. Washing Machine: ☒ Yes ☐ No

Other ____


☐ Basement wo/plumbing

Comments Owner decided not To place Garbage disposal on System. mobile Home was not located at time of this inspection Keep Proper distances from System well not located at this time (5')

INITIAL SITE SKETCH

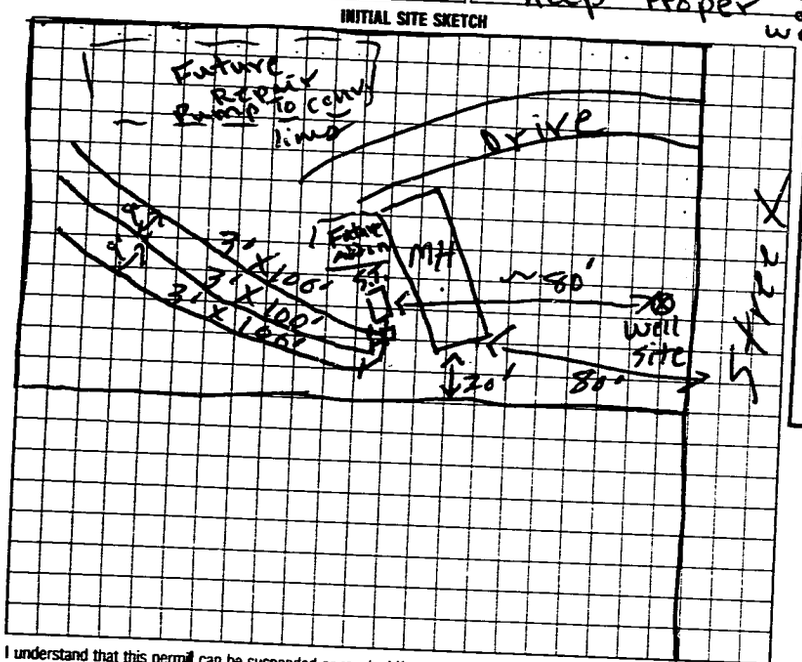

AS BUILT SKETCH

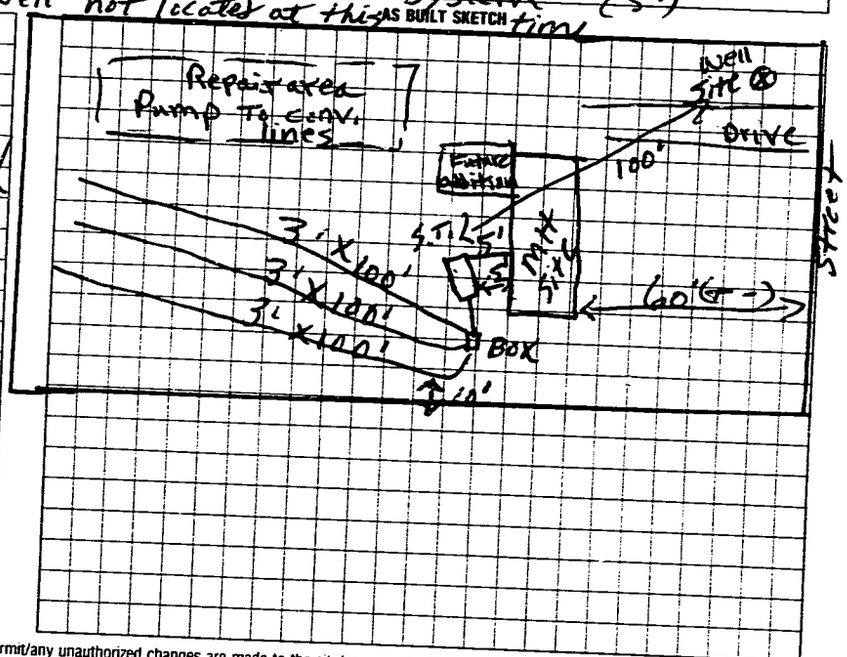

I understand that this permit can be suspended or revoked if any false information is supplied toward securing the permit/any unauthorized changes are made to the site/any unauthorized changes are made in the installation of the system. Improvement Permit is valid for 60 months from date of issuance.

Signed: ~~X~~ David Crooks

Improvement Permit by: J.C. Moore date 6-29-93

Existing System Inspection by: ____ date ____

Installed by: Young S.T.

Certificate of Completion by: J.C. Moore date 7-12-93

Operation Permit by: ____ date ____

HEALTH DEPT. COPY: WHITE INSPECTION COPY (FINAL): GREEN OWNER COPY (FINAL): YELLOW INSPECTION COPY (INITIAL): PINK OWNER COPY (INITIAL): GOLD