James Hudder

IREDELL COUNTY HEALTH DEPARTMENT

STATESVILLE 704-878-5305 MOORESVILLE 704-664-5281

IMPROVEMENT PERMIT / CERTIFICATE OF COMPLETION / OPERATION PERMIT / EXISTING SYSTEM INSPECTION

PROPERTY DESCRIPTION NO 66637 DATE 5-29-97 TAX MAP NO. 4752937838 Watershed: ☐ Yes ☑ No

OWNER OR CONTRACTOR Phillip Lloyd PHONE: Business Home 872-9040

ADDRESS 434 Clemments Rd Sta. N.C.

LOCATION 70E TR Shiloh 76 Clemments Corner Bevis Lane

SUBDIVISION Lloyd Acres BLOCK / SECTION LOT 1R LOT AREA .63acres SITE CLASS PS DESIGN FLOW 360 L.T.A.R. .33

Septic Tank: 1000 Gallons; STB 794 Veltex Date 5/19/97
Pump Tank: Gallons; PT Date
Pump Make: Model Serial No.
Nitrification Field: No Fields 1 Square Feet 1080 Linear Feet 360
No Lines 4 Trench Width 24" Max Trench Bottom Depth 36" Gravel Depth 12"

☑ New System ☐ Repair System Type: I, II, III, IV, V, VI
System Description: Conv. Gravity
Repair System Description: Gravity Chambers
Maintenance Agreement Required: ☐ Yes ☐ No

☑ House/Mod. Home ☑ Mobile Home ☐ Business ☐ Other
No. Bedrooms 3 No. Bathrooms 2 No. Employees


☐ Slab ☑ Crawl Space ☐ Basement w/plumbing ☐ Basement wo/plumbing

Water Supply: ☑ Individual ☐ Community ☐ Public


Comments:

Comments:

INITIAL SITE SKETCH

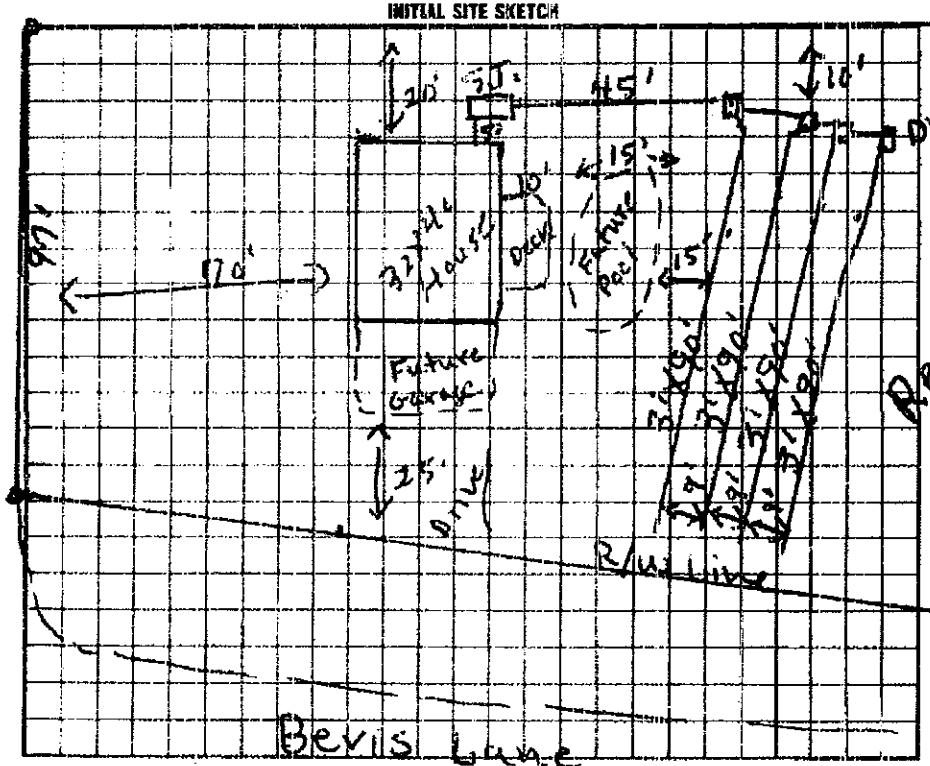

AS BUILT SKETCH

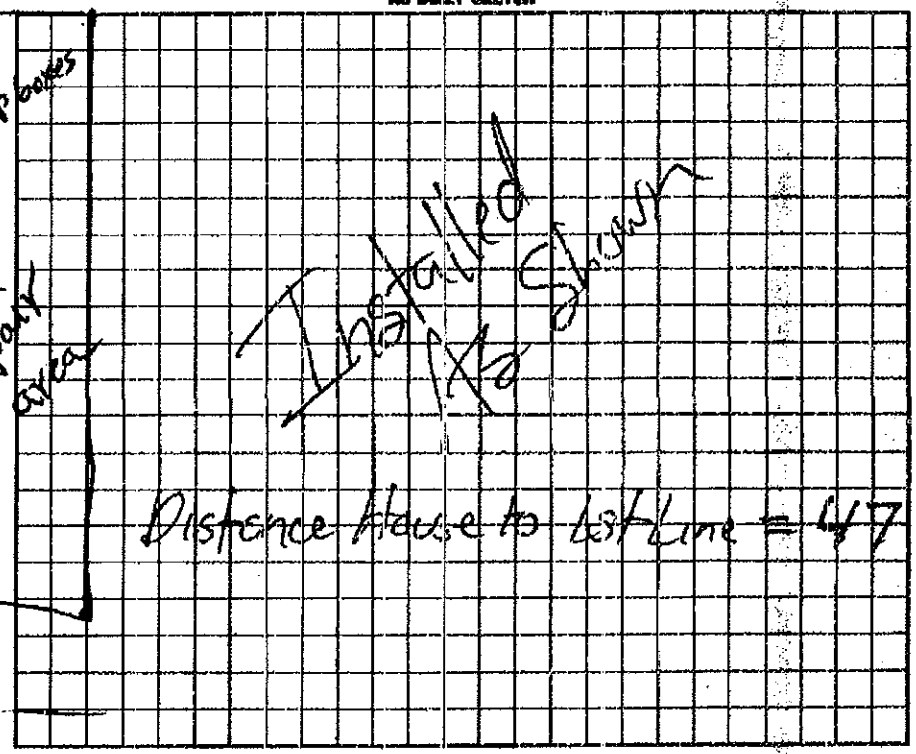

I understand that this permit can be suspended or revoked if any false information is supplied toward securing the permit/any unauthorized changes are made to the site/any unauthorized changes are made in the installation of the system. Improvement Permit is valid for 60 months from date of issuance.

Signed: X Phillip R. Lloyd

Improvement Permit by: E. C. Moore date 5-29-97

Existing System Inspection by: E. C. Moore date 5-29-97

Installed by: James Hudder

Certificate of Completion by: date

Operation Permit by: date 8/7/97

to Owner WHITE COPY (FINAL): GREEN OWNER COPY (FINAL): YELLOW INSPECTION COPY (INITIAL): PINK OWNER COPY (INITIAL): GOLD

Installed Chamber System

Authorization to Count. Expires 60 mos from issued

JAN. 1, 1989 0:35