IREDELL COUNTY HEALTH DEPARTMENT

STATESVILLE 704-878-5305 (P) (@) MOORESVILLE 704-664-5281

IMPROVEMENT PERMIT / AUTHORIZATION TO CONSTRUCT / OPERATION PERMIT / EXISTING SYSTEM INSPECTION

DATE 5-23-05

PERMIT# 127222 PIN# 4752-93-9548

OWNER OR CONTRACTOR VINCENT MATTOX PHONE: Business 704-450-4124 Home

ADDRESS 2105 BEAUTY ST, STATESVILLE, NC 28677

LOCATION US 70 WEST, TR STILLOH RD, TL CLEMENTS RD, TR BEVIS LANE 0.2 MILE ON LEFT

SUBDIVISION LOYD ACRES BLOCK / SECTION LOT 13 LOT AREA 0.45 ACRE SITE CLASS. PS DESIGN FLOW 360 L.T.A.R. 0.20 GPD/FT²

Septic Tank: 1000 Gallons; STB 760 Date 5-22-10

Pump Tank: Gallons; PT Date

Pump Make: Model Serial No.

Nitrification Field: No Fields 1 Square Feet EST 1800 Linear Feet 450

No Lines EIGHT Trench Width 36" Max Trench Bottom Depth 36" Gravel Depth N/A

☑ New System ☐ Repair System Type: I, II, III, IV, V, VI

System Description: 25% REDUCTION, GRAVITY

Repair System Description: MAX. FEASIBLE (.1945)

Maintenance Agreement Required: ☐ Yes ☑ No

☑ House/Mod. Home ☐ Mobile Home ☐ Business ☐ Other

No. Bedrooms 3 No. Bathrooms No. Employees


☐ Slab ☑ Crawl Space ☐ Basement w/plumbing ☐ Basement wo/plumbing

Water Supply: ☑ Individual ☐ Public ☐ Community WELL


Comments:/Conditions: (1) INSTALL 25% REDUCTION SYSTEM ON CONTOUR (2) INSTALL SUBSURFACE INTERCEPT DRAINAGE DITCH AT LOCATION SHOWN, 48 INCHES DEEP OUT TO DAYLIGHT.

Comments:/Conditions: Poly/Loc Filter tee

INITIAL SITE SKETCH

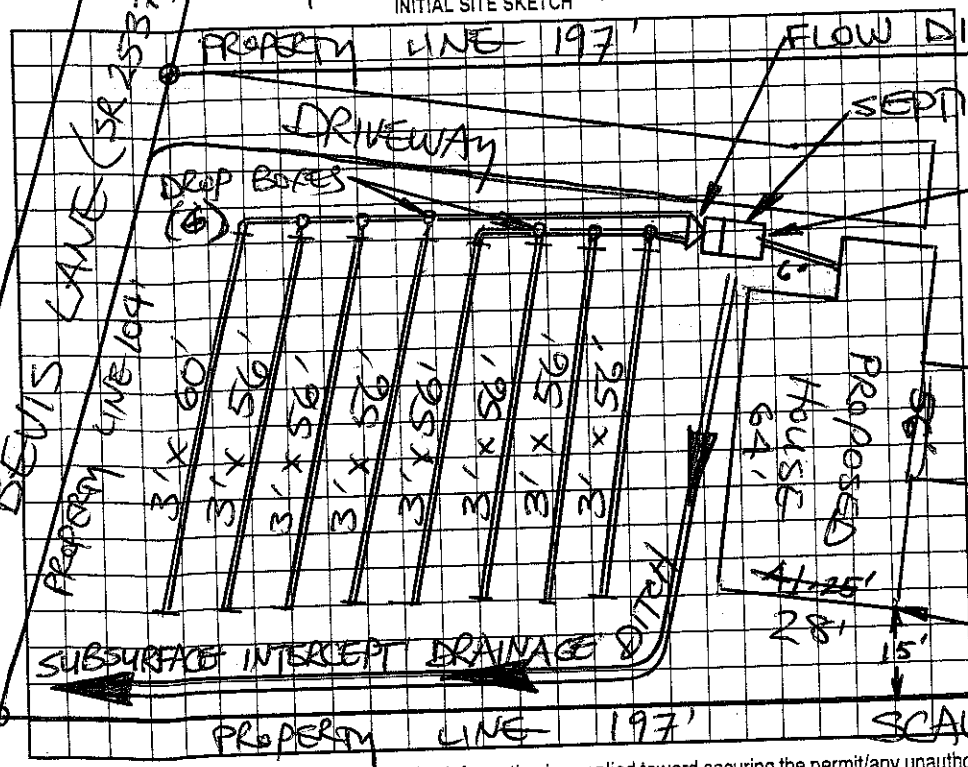

AS BUILT SKETCH

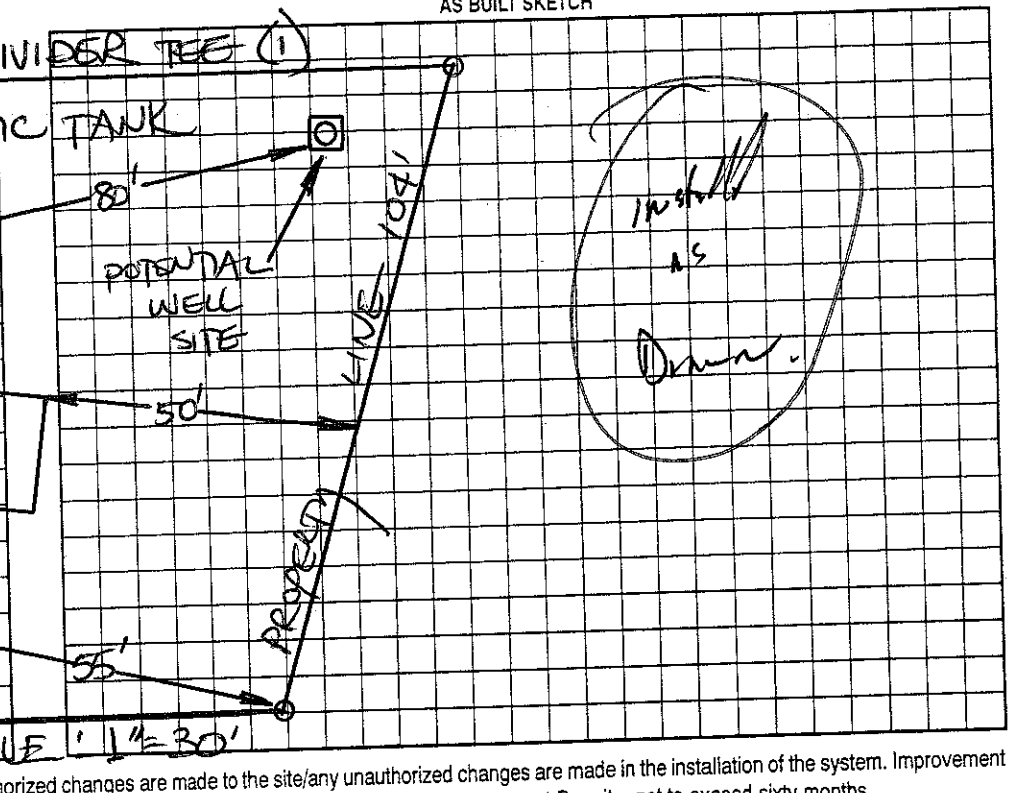

Permit can be suspended or revoked if any false information is supplied toward securing the permit/any unauthorized changes are made to the site/any unauthorized changes are made in the installation of the system. Improvement Permit with plat valid without expiration. Improvement Permit with site plan valid for sixty months. Authorization to Construct is valid for a period equal to that of Improvement Permit – not to exceed sixty months.

Patricia Mattox date 5/26/05

Permit by: STEVE HEDRICK date 5-23-05

to Construct by: STEVE HEDRICK date 5-23-05

Installed by: Jim Shea date 21 September 10

Operation Permit by: date

Existing System Inspection by: date

HEALTH DEPT. COPY: WHITE OWNER COPY (FINAL): YELLOW OWNER COPY (INITIAL): PINK