3

IREDELL COUNTY HEALTH DEPARTMENT

Statesville Office (704) 878-5305 Mooresville Office (704) 660-3625 PERMIT # 214549

IMPROVEMENT PERMIT / AUTHORIZATION TO CONSTRUCT / OPERATION PERMIT / EXISTING SYSTEM

PIN # 4752-93-9863.000 ✓

APPLICANT: Clayton Hames APPLICANT ADDRESS: 2026 Northside Dr. Statesville NC

SITE ADDRESS: 246 Clements Rd. Statesville NC 28677 PHONE: 704-873-2547 ALT. PHONE: 704-902-4653

SITE DIRECTIONS: Amity Hill to Shiloh Rd., Tr Clements, Site on R


SUBDIVISION: — SECTION: — LOT # — LOT AREA: 2.440 Acres DESIGN FLOW: 360 GPD L.T.A.R.: .3 I /.25 R

Septic Tank	1000 (gal)	STB	760	Date	2-9-16	☒ New System	☐ Repair	☐ Expansion	System Type: I II (III) IV V VI	☒ Residence	No. Bedrooms 3
Pump Tank	N/A (gal)	PT	N/A	Date	N/A	System Description:	25% Reduction - Gravity			☐ Business	No. Persons 6
Pump Make	N/A	Model	Polylok	Serial #	PL-66	Repair System Description:	Same			☐ Other	No. Employees
# Nitrification Fields	1	# Lines	3 @ 100'	Linear Ft:	300'	Maintenance Agreement Required:	☐ YES	☒ NO		☐ Slab	☒ Crawl Space
Trench Width	36"	Max. Trench Bottom Depth	* 25" *	Gravel Depth	N/A		☒ GRAVITY	☐ PRESSURE		☐ Basement w/plumbing	☐ Basement w/o plumbing

Water Supply: ☒ Private ☐ Public ☐ Community

Comments / Conditions: In the case of Repair Being Installed, Berm Downhill of Repair Area will need to be Removed.

INITIAL SITE SKETCH

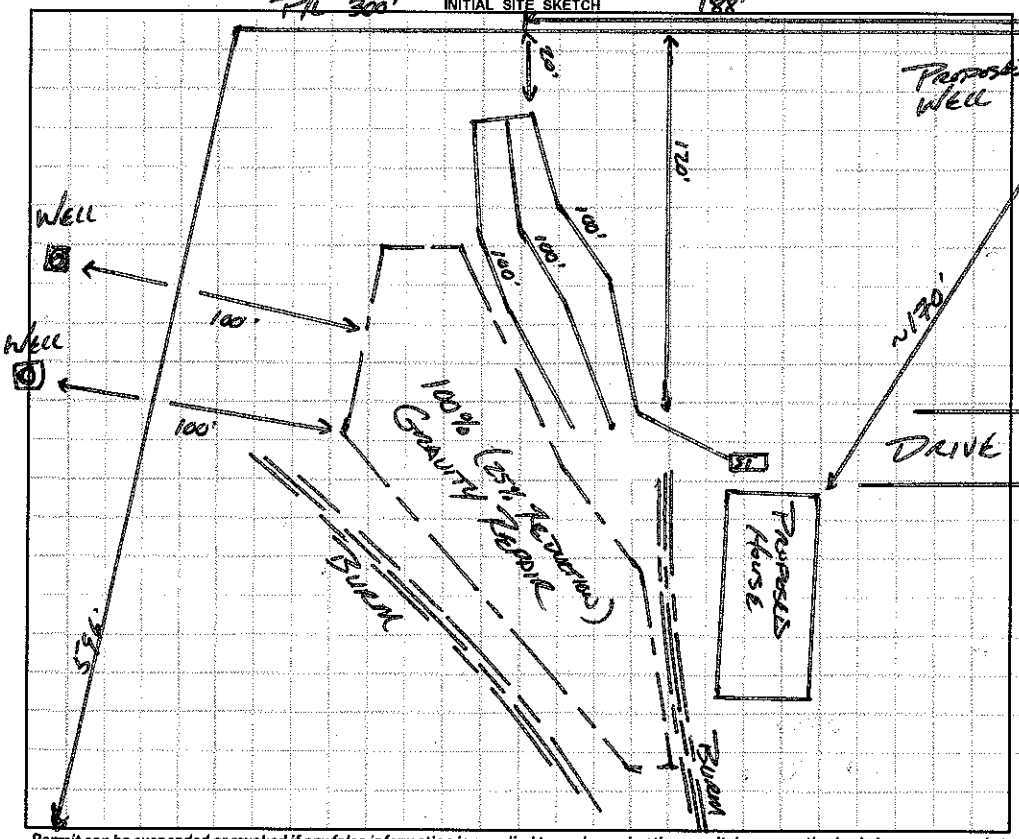

AS BUILT SKETCH

1" = 60'

Installed as drawn

Quilt 4

Permit can be suspended or revoked if any false information is supplied toward securing the permit / any unauthorized changes are made to the site / any unauthorized changes are made in the installation of the system. **CONTACT A LOCATOR SERVICE PRIOR TO ANY EXCAVATION**

☐ **IMPROVEMENT PERMIT** *with plat* valid without expiration. ☒ **IMPROVEMENT PERMIT** *with site plan* valid for 60 mos. ☒ **AUTHORIZATION TO CONSTRUCT** valid for period equal to IMPROVEMENT PERMIT--not to exceed 60 mo.

Owner / Applicant Signature: Brooke Lee Date: 4-1-16 Installed by: Bryant Septic

IMPROVEMENT PERMIT by: APPROVED Date: DEC 07 2015 OPERATION PERMIT by: Date: 04/13/16

AUTHORIZATION TO CONSTRUCT by: APPROVED Date: DEC 07 2015 Existing System Inspected by: Date:

Health Dept. Copy - WHITE Applicant (Final Approval) - YELLOW Applicant (Conditional Approval) - PINK