IREDELL COUNTY HEALTH DEPARTMENT

West Lincoln

STATESVILLE 704-878-5305 MOORESVILLE 704-664-5281

49309

IMPROVEMENT PERMIT / CERTIFICATE OF COMPLETION / OPERATION PERMIT / EXISTING SYSTEM INSPECTION

PROPERTY DESCRIPTION NO. 17378 DATE 11-8-93 TAX MAP NO. 5E-1-A-47

OWNER OR CONTRACTOR Kevin K. Lyon PHONE: Business Watershed: ☐ Yes ☒ No

ADDRESS 130 Cava Ln Sta Home 878-9638

LOCATION 70E TR Shiloh Ch Rd TL Clemments 1/2 mi ON left

SUBDIVISION Rebecca Sa BLOCK / SECTION 2 LOT 7 LOT AREA 1.62 SITE CLASS. PS DESIGN FLOW 360 L.T.A.R. .4

Septic Tank: 1000 Gallons; STB 786 Date 9-22-93

Pump Tank: Gallons; PT Date

Pump Make: Model Serial No.

Nitrification Field: No Fields 1 Square Feet 900 Linear Feet 300

No Lines 3 Trench Width 36" Max Trench Bottom Depth 36" Gravel Depth 12"

☒ New System ☐ Repair System Type: I, II, III, IV, V, VI

System Description: Conv. Gravity

Repair System Description: " "

Maintenance Agreement Required: ☐ Yes ☒ No

☐ Slab ☒ Crawl Space ☐ Basement w/plumbing ☐ Basement wo/plumbing

☐ House/Mod. Home ☒ Mobile Home ☐ Business ☐ Other


No. Bedrooms 3 No. Bathrooms 2 No. Employees

Water Supply: ☒ Individual ☐ Community ☐ Public


Comments:

Comments:

INITIAL SITE SKETCH

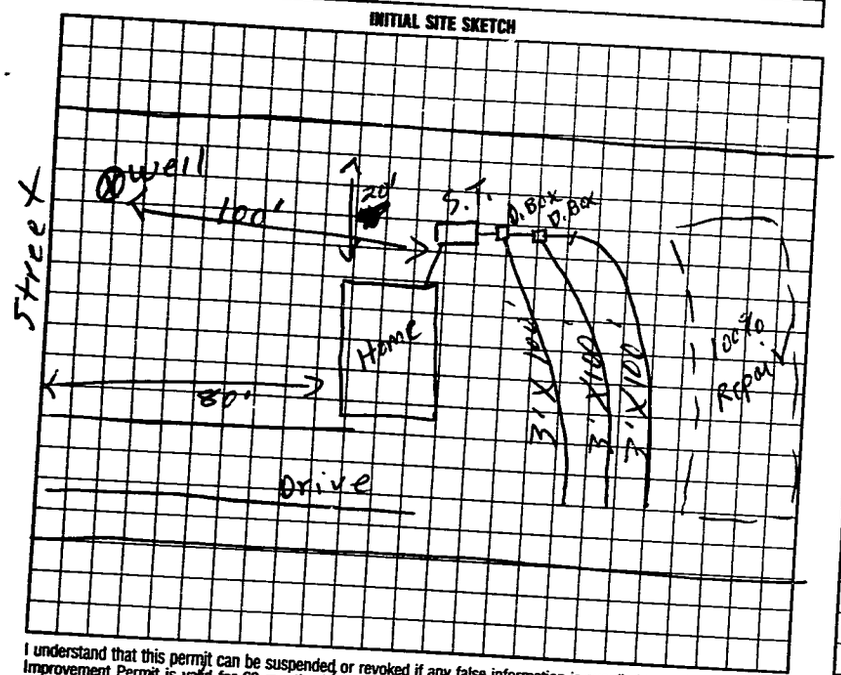

AS BUILT SKETCH

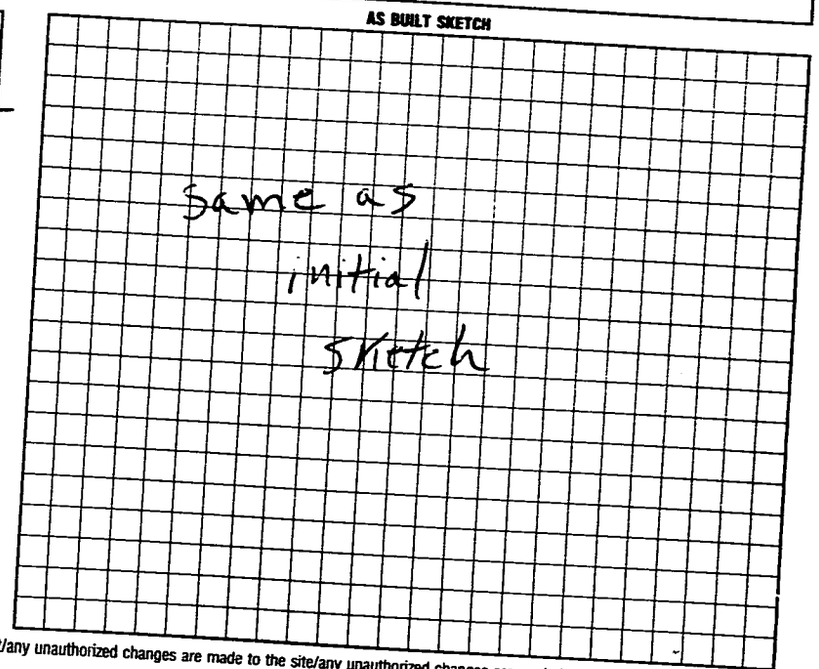

I understand that this permit can be suspended or revoked if any false information is supplied toward securing the permit/any unauthorized changes are made to the site/any unauthorized changes are made in the installation of the system. Improvement Permit is valid for 60 months from date of issuance.

Signed: X Kevin Kent Lyon

Improvement Permit by: P. C. Moore date 11-8-93

Existing System Inspection by: date

Installed by: West Lincoln Const.

Certificate of Completion by: P. C. Moore date 12-9-93

Operation Permit by: date

HEALTH DEPT. COPY: WHITE INSPECTION COPY (FINAL): GREEN OWNER COPY (FINAL): YELLOW INSPECTION COPY (INITIAL): PINK OWNER COPY (INITIAL): GOLD