IREDELL COUNTY HEALTH DEPARTMENT

STATESVILLE 704-878-5305 MOORESVILLE 704-664-5281

IMPROVEMENT PERMIT / AUTHORIZATION TO CONSTRUCT / OPERATION PERMIT / EXISTING SYSTEM INSPECTION

PERMIT# REPAIR PIN# 4753-36-3947 DATE

OWNER OR APPLICANT ENRIQUETA NUNEZ-VARGAS PHONE: Business Home 704-881-1460 (LETICIA)

ADDRESS 153 EAST BARKLEY ROAD STATESVILLE NC 28625

LOCATION US 70 EAST, TR EAST BARKLEY ROAD, HOUSE ON LEFT AT HODGE LANE

SUBDIVISION KELLER ACRES BLOCK / SECTION LOT 32 LOT AREA 100'X200' SITE CLASS. P3 DESIGN FLOW 420 L.T.A.R. EXISTING 0.3 GPD/FT2

Septic Tank: EXISTING Gallons: STB Date

Pump Tank: Gallons: PT Date

Pump Make: Model Serial No.

Nitrification Field: No. Fields 1 Square Feet EQUIV 720 Linear Feet 180

No. Lines ONE Trench Width 36" Max Trench Bottom Depth 36" Gravel Depth N/A

☐ New System ☑ Repair ☐ Expansion System Type: I (II) III IV V VI

System Description:

Repair System Description: 25% REDUCTION, GRAVITY

Maintenance Agreement Required: ☐ Yes ☑ No

☑ House/Mod. Home ☐ Mobile Home ☐ Business ☐ Other 7@60 GPD

No. Bedrooms 3 No. Persons 7 No. Employees


Water Supply: ☑ Individual ☐ Public ☐ Community WELL

☑ Gravity ☐ Pressure ☐ Slab ☑ Crawl Space ☐ Basement w/plumbing ☐ Basement wo/plumbing


Comments:/Conditions: INSTALL NEW 3'X180' DRAINLINE USING 25% REDUCTION SYSTEM AS FLAGGED ON SITE (SEE DETAIL) SYSTEM TO BE REPAIRED BY NOVEMBER 4, 2007 (SEE NOV)

Comments:/Conditions:

INITIAL SITE SKETCH

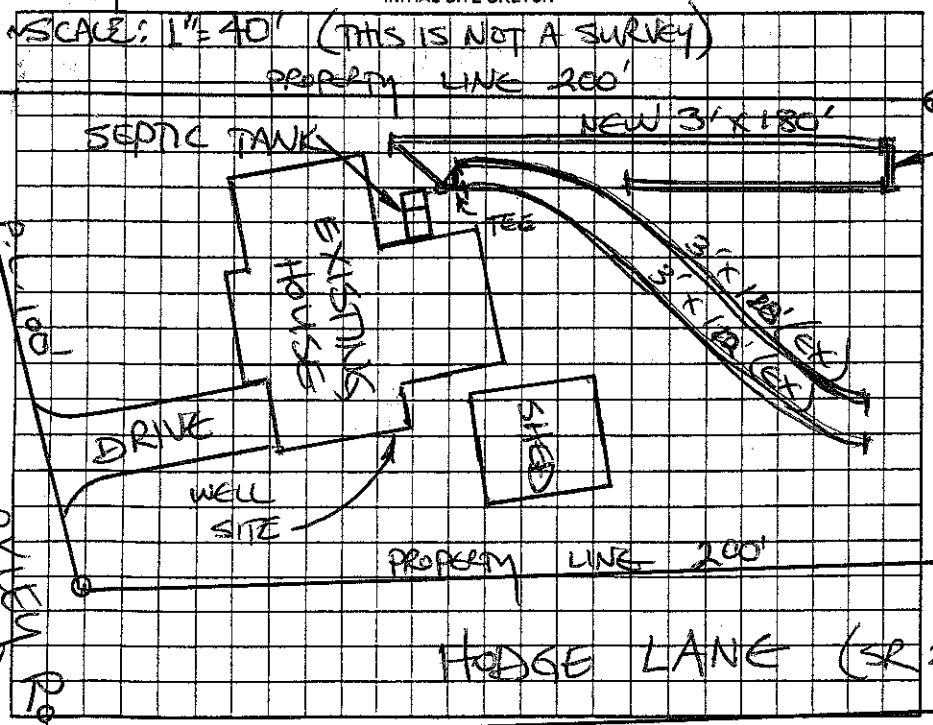

AS BUILT SKETCH

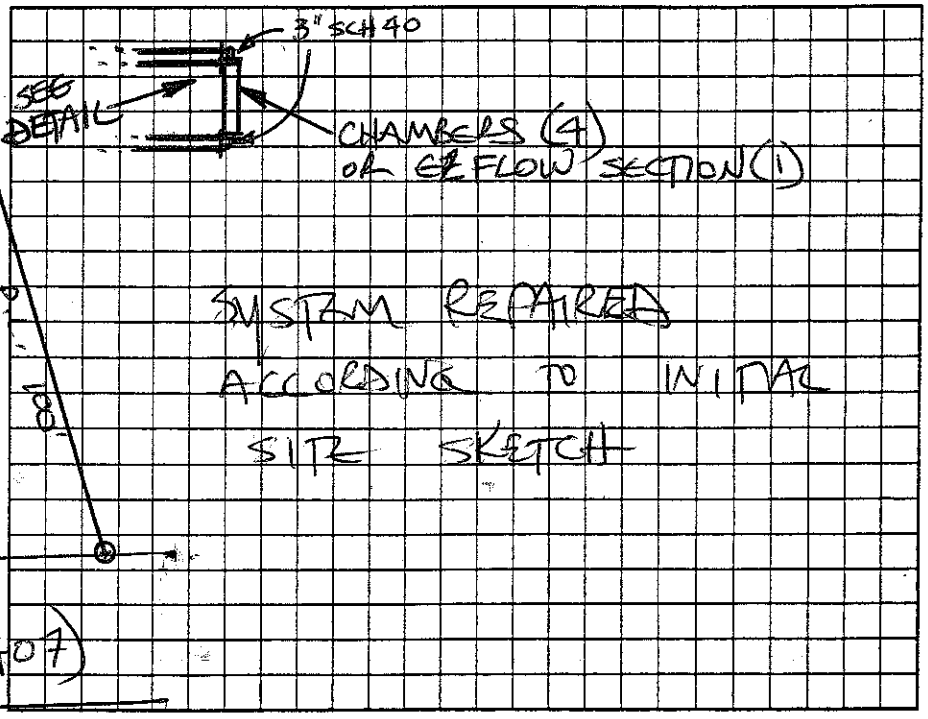

Permit can be suspended or revoked if any false information is supplied toward securing the permit/any unauthorized changes are made to the site/any unauthorized changes are made in the installation of the system. Improvement Permit with plat valid without expiration ☐ Improvement Permit with site plan valid for sixty months ☑ Authorization to Construct is valid for a period equal to that of Improvement Permit – not to exceed sixty months.

Signed: SAL Nunez date 10-19-07 Installed by: SCOTT GREENE

Improvement Permit by: STEVE HEDRICK date 10-19-07 Operation Permit by: STEVE HEDRICK date 11-16-07

Authorization to Construct by: STEVE HEDRICK date 10-19-07 Existing System Inspection by: date

HEALTH DEPT. COPY: WHITE OWNER COPY (FINAL): YELLOW OWNER COPY (INITIAL): PINK