IREDELL COUNTY HEALTH DEPARTMENT

Statesville Phone TR 3-7271 Mooresville Phone NO 3-1271

PERMIT TO INSTALL SEPTIC TANK

Permit NO. _____ Permit Date 2-2 1963

Owner RUSSELL WILSON Address _____

Installed By SELF Address _____

Location of Property DOWN #70 E. RIGHTON 1st DIRT ROAD


PAST PENNY'S WHSE 1st DIRT ROAD LEFT 1st BRICK

Tank		Capacity		Length of Lines		Fixtures	
Block	(✓)	800	( )	150'	( )	No. of Baths	(1½)
Precast	( )	900	( )	175'	( )	Dishwasher	( )
		1000	( )	200'	( )	Garbage Grdr.	( )
		1100	( )	225'	(✓)	Auto-Washer	( )
		1200	(✓)	250'	( )	Other	_____
		Other	_____	Other	_____		

NOTIFY HEALTH DEPARTMENT AT LEAST EIGHT HOURS BEFORE TANK IS TO BE INSPECTED.

Final Inspection 2-2 1963 Approved (✓) Disapproved ( )

Remarks _____

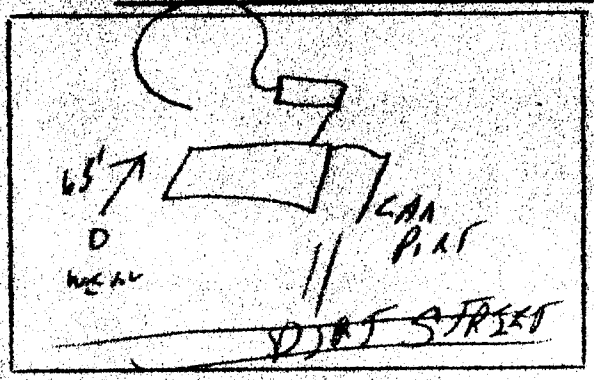

Sketch of Installation

Sanitarian