THIS PERMIT SERVES AS NOTICE OF VIOLATION

IREDELL COUNTY HEALTH DEPARTMENT

STATESVILLE 704-878-5305 MOORESVILLE 704-664-5281

IMPROVEMENT PERMIT / AUTHORIZATION TO CONSTRUCT / OPERATION PERMIT / EXISTING SYSTEM INSPECTION

PERMIT# REPAIR PIN# 4753 37 1839 DATE 8-9-00

OWNER OR CONTRACTOR VICENCIO SANTIBANEZ PHONE: Business Home 872-8354

ADDRESS 1902 SALISBURY ROAD, STATESVILLE, NC 28677

LOCATION US 70 EAST, LOT ON RIGHT AT E. BARKLEY ROAD.

SUBDIVISION BLOCK / SECTION LOT LOT AREA LIMITED SITE CLASS PS DESIGN FLOW 360 L.T.A.R. EXISTING

Septic Tank: EXISTING Gallons: STB Date

Pump Tank: Gallons: PT Date

Pump Make: Model Serial No.

Nitrification Field: No Fields 1 Square Feet 540 Linear Feet 180

No Lines THREE Trench Width 36" Max Trench Bottom Depth AS SHALLOW AS POSSIBLE

☑ New System ☐ Repair System Type: I, II, III, IV, V, VI

System Description:

Repair System Description: CONVENTIONAL GRAVITY

Maintenance Agreement Required ☐ Yes ☑ No

☑ House/Mod. Home No. Bedrooms 3

☐ Mobile Home No. Bathrooms 2

☐ Business No. Employees

☐ Other

Gravel Depth 24" ☐ Slab ☐ Crawl Space ☐ Basement w/plumbing ☐ Basement wo/plumbing


Water Supply: ☑ Individual ☐ Public ☐ Community WELL

Comments/Conditions: ① INSTALL NEW LINES AS SHALLOW AS POSSIBLE USING 24" STONE (MAY INTERSECT OLD LINES) ② FILL AREA OF LOW LYING FAILING SYSTEM ③ SYSTEM TO BE REPAIRED BY SEPTEMBER 10, 2000


Comments/Conditions:

SCALE: 1" = 40'

INITIAL SITE SKETCH

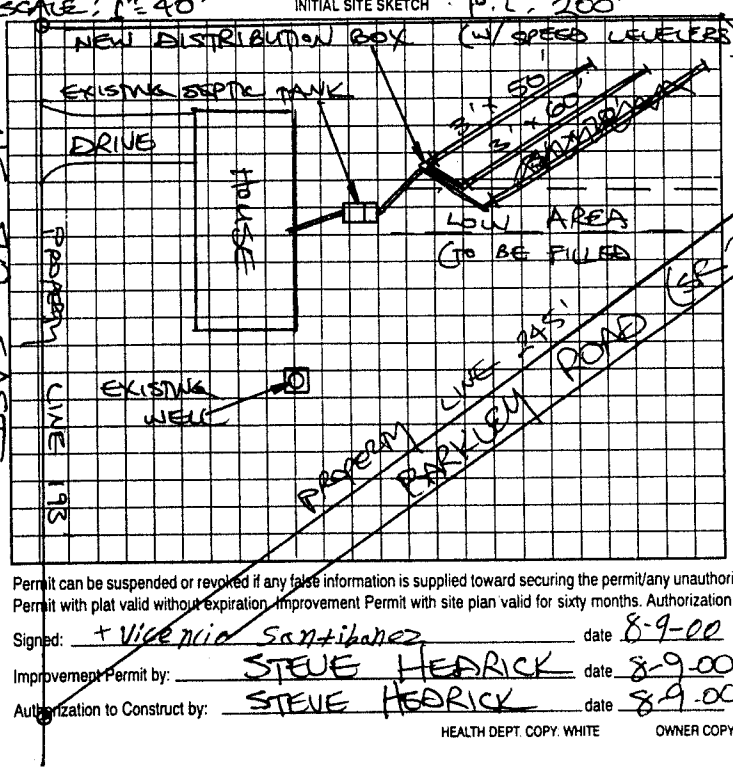

AS BUILT SKETCH

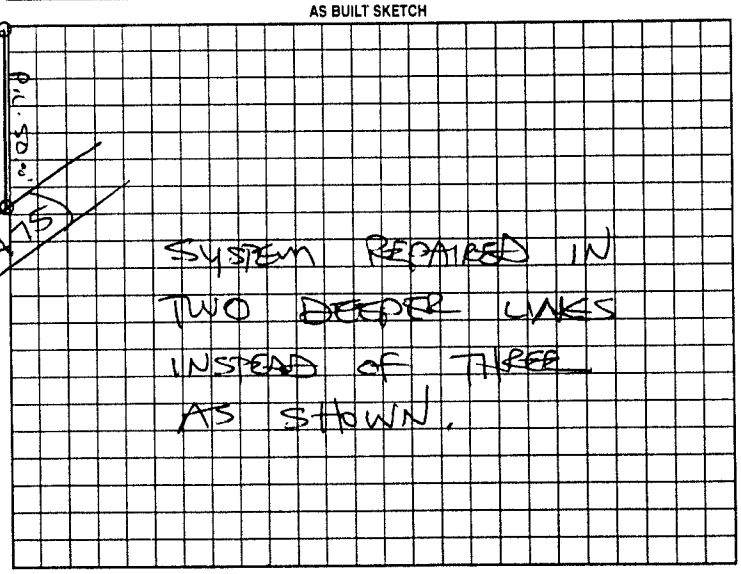

Permit can be suspended or revoked if any false information is supplied toward securing the permit/any unauthorized changes are made to the site/any unauthorized changes are made in the installation of the system. Improvement Permit with plat valid without expiration. Improvement Permit with site plan valid for sixty months. Authorization to Construct is valid for a period equal to that of Improvement Permit – not to exceed sixty months.

Signed: + Vicencio Santibanez date 8-9-00 Installed by: BARRY SIGMON

Improvement Permit by: STEVE HEDRICK date 8-9-00 Operation Permit by: STEVE HEDRICK date 8-29-00

Authorization to Construct by: STEVE HEDRICK date 8-9-00 Existing System Inspection by: date

HEALTH DEPT. COPY: WHITE OWNER COPY (FINAL): YELLOW OWNER COPY (INITIAL): PINK