IREDELL COUNTY HEALTH DEPARTMENT - *ENVIRONMENTAL HEALTH* ☐ STATESVILLE OFFICE 704-878-5305 ☐ MOORESVILLE OFFICE 704-664-5281

IMPROVEMENT PERMIT / AUTHORIZATION TO CONSTRUCT / OPERATION PERMIT / EXISTING SYSTEM INSPECTION

PERMIT # REPAIR PIN # 4753-37-5042 DATE MARCH 5 2012

OWNER DAN E. MEDLIN APPLICANT: JARED LENTZ PHONE: Home/Cell # 704-902-4602 Business # 704-876-9938

SITE ADDRESS 117 HODGE LANE, STATES OWNER / APPLICANT ADDRESS SAME

SITE DIRECTIONS US 70 EAST, TR E. BARKLEY ROAD, TL HODGE LANE, 1ST DRIVE ON LEFT

SUBDIVISION KELLER ACRES BLOCK / SECTION LOT # 75 LOT AREA 1.071 ACRES DESIGN FLOW 240 L.T.A.R. 0.30 GPD/FT2

Septic Tank EXISTING Gallons: STB 760 Date 11-9-11

Pump Tank 1000 Gallons: P.T. Date

Pump Make Model Serial #

No. Nitrification Fields: 1 No. Lines 3 Linear Feet 200+

Trench Width 36" Max. Trench Bottom Depth 36" Gravel Depth N/A

☐ New System ☑ Repair ☐ Expansion System Type I II (III) IV V VI

System Description:

Repair System Description: 25% REDUCTION, GRAVITY

Maintenance Agreement Required ☐ YES ☑ NO

☑ GRAVITY ☐ PRESSURE

☑ Residence No. Bedrooms 2

☐ Business No. Persons

☐ Other No. Employees


☐ Slab ☐ Crawl Space

☐ Basement w/plumbing ☑ Basement w/o plumbing


Water Supply: ☑ Private WELL ☐ Public ☐ Community

Comments / Conditions ① INSTALL NEW 25% REDUCTION SYSTEM AT LOCATION SHOWN ② KEEP SYSTEM MINIMUM 50 FEET FROM WELL & 5 FEET FROM PROPERTY LINE ③ REMOVE EXISTING MAPLE TREE AS SHOWN.

INITIAL SITE SKETCH

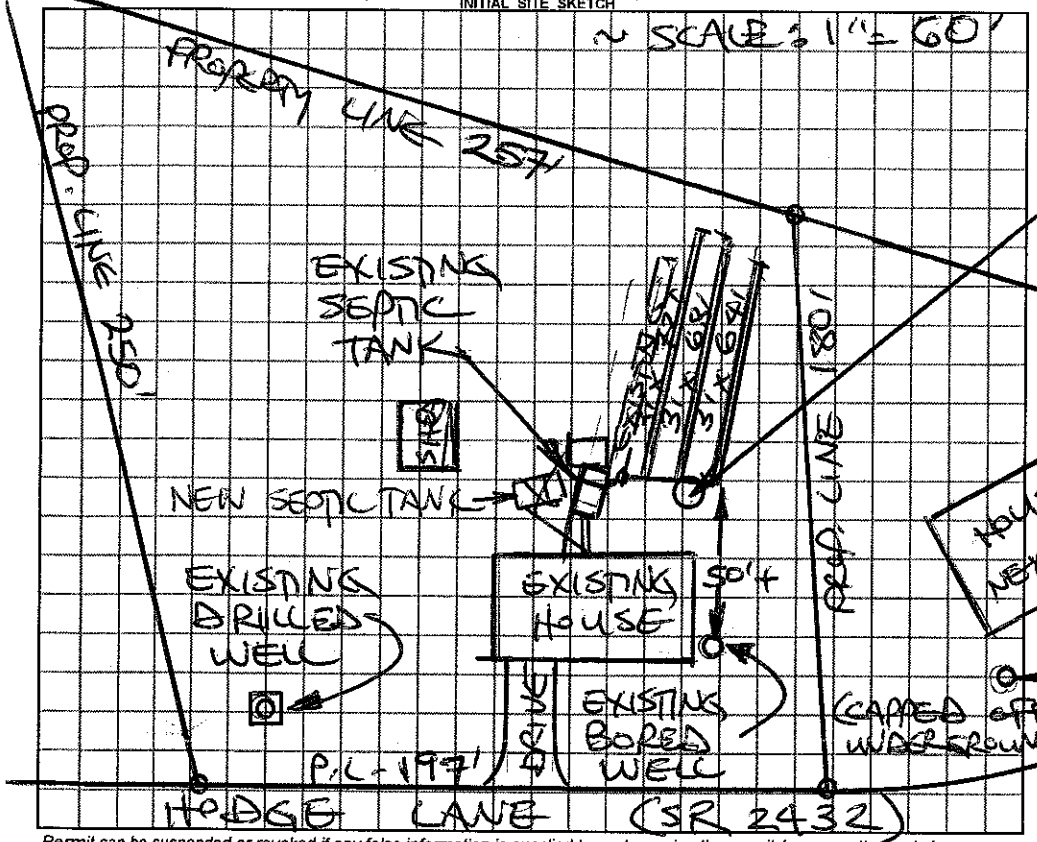

AS BUILT SKETCH

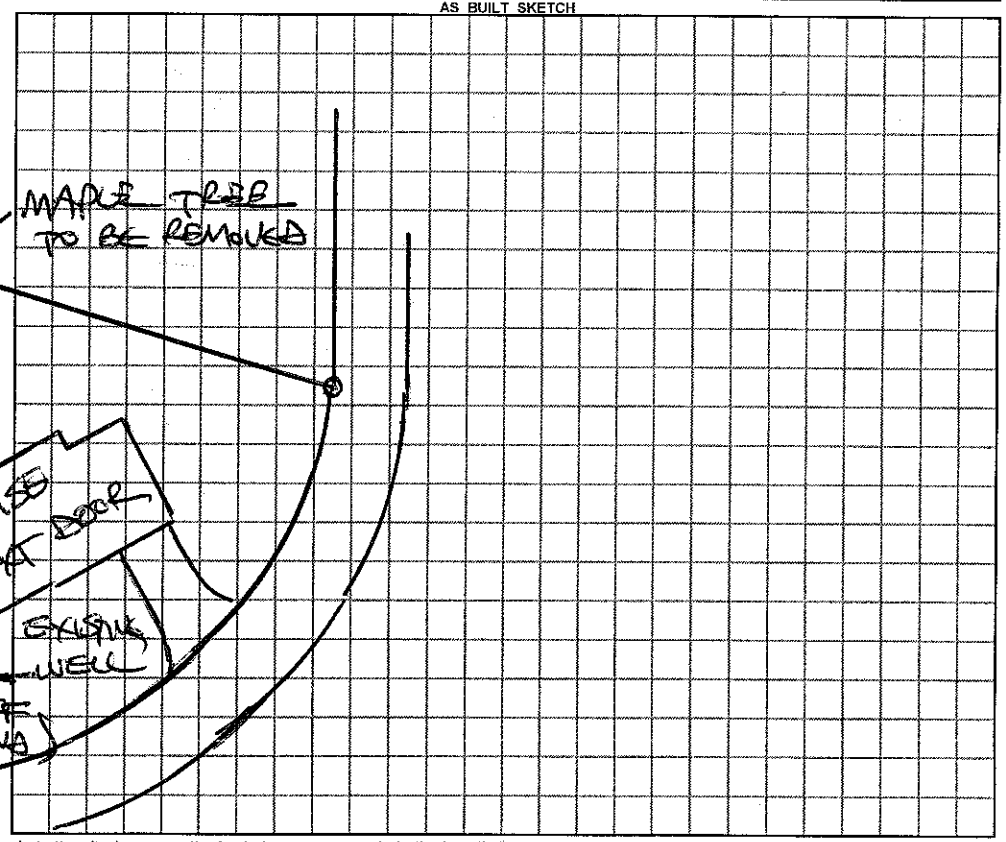

Permit can be suspended or revoked if any false information is supplied toward securing the permit / any unauthorized changes are made to the site / any unauthorized changes are made in the installation of the system.

☐ ***IMPROVEMENT PERMIT*** with plat valid without expiration. ☑ ***IMPROVEMENT PERMIT*** with plat valid without expiration. Site plan valid 60 mo. ☑ ***AUTHORIZATION TO CONSTRUCT*** valid for period equal to IMPROVEMENT PERMIT--not to exceed 60 mo.

Owner / Applicant Signature: Date 3-6-12 Installed by: A-1 Backhoe

IMPROVEMENT PERMIT by: STEVE HENDRICK REHS Date 3/5/2012 OPERATION PERMIT by: REHS Date 3-16-17

AUTHORIZATION TO CONSTRUCT by: STEVE HENDRICK REHS Date 3/5/2012 Existing System Inspected by: REHS Date

YOU SHOULD CONTACT A LOCATOR SERVICE PRIOR TO ANY EXCAVATION

White Copy – Environmental Health YELLOW COPY (Final) Owner / Applicant PINK COPY (Initial) Owner / Applicant