IREDELL COUNTY HEALTH DEPARTMENT - *ENVIRONMENTAL HEALTH* ☑ STATESVILLE OFFICE 704-878-5305 ☐ MOORESVILLE OFFICE 704-664-5281 2-2-30

IMPROVEMENT PERMIT / AUTHORIZATION TO CONSTRUCT / OPERATION PERMIT / EXISTING SYSTEM INSPECTION

PERMIT # 173345 PIN # 4753407477 DATE 7-19-12

OWNER William Poole APPLICANT: Stikeleather Builders PHONE: Home/Cell # 704-873-9789 Business # N/A

SITE ADDRESS 411 Third Creek Rd. OWNER / APPLICANT ADDRESS PO Box 585 Statesville NC 28687

SITE DIRECTIONS Hwy 70 to Third Creek Rd.

SUBDIVISION N/A BLOCK / SECTION N/A LOT # N/A LOT AREA 8.6 acres DESIGN FLOW 480gpd L.T.A.R. 0.25

Septic Tank 1000 Gallons: STB 1012 Date 12-21-11

Pump Tank ____ Gallons: P T ____ Date ____

Pump Make ____ Model ____ Serial # ____

No. Nitrification Fields: 1 No. Lines 5 Linear Feet 640

Trench Width 36" Max. Trench Bottom Depth 36" Gravel Depth 12"

☑ New System ☐ Repair ☐ Expansion System Type I (II) III IV V VI

System Description: Conventional - gravity

Repair System Description: 25% Reduction

Maintenance Agreement Required ☐ YES ☑ NO

☑ GRAVITY ☐ PRESSURE

☑ Residence No. Bedrooms 4

☐ Business No. Persons ____

☐ Other No. Employees ____


☐ Slab ☐ Crawl Space

☐ Basement w/plumbing ☐ Basement w/o plumbing


Water Supply: ☐ Private ☑ Public ☐ Community

Comments / Conditions - Pump + crush old septic tank prior to start of construction of proposed addition. Install Conventional system on contour with serial distribution. An accepted system may also be installed.

INITIAL SITE SKETCH

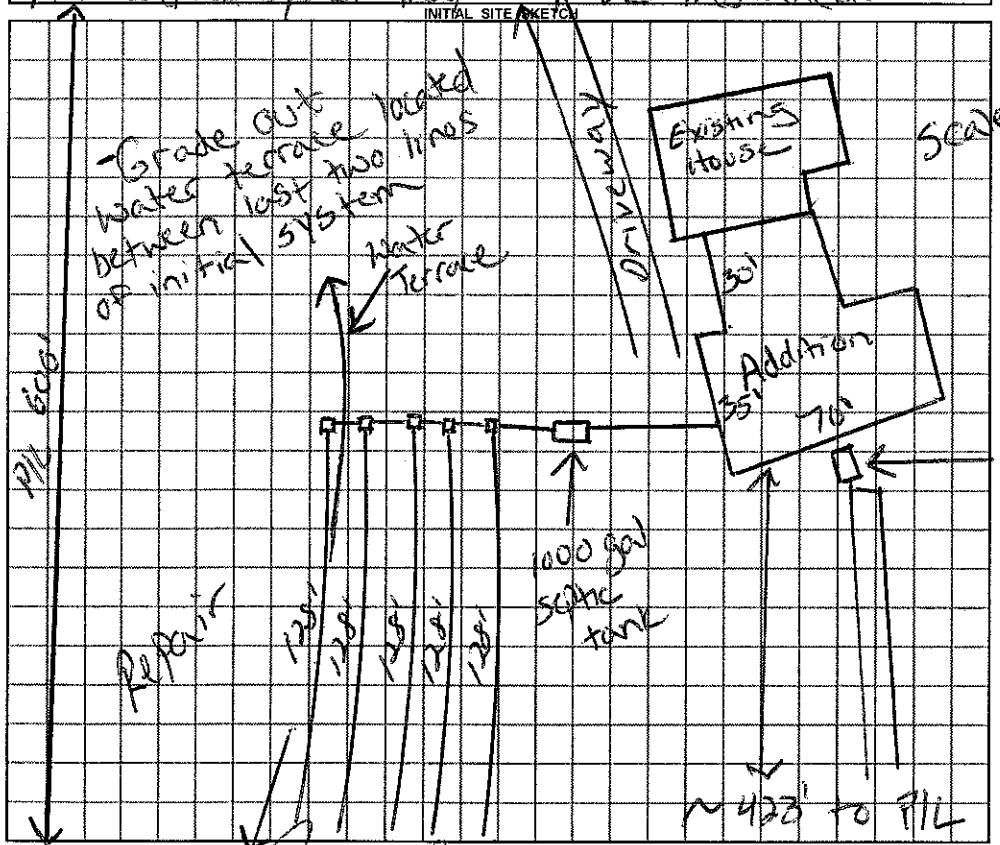

AS BUILT SKETCH

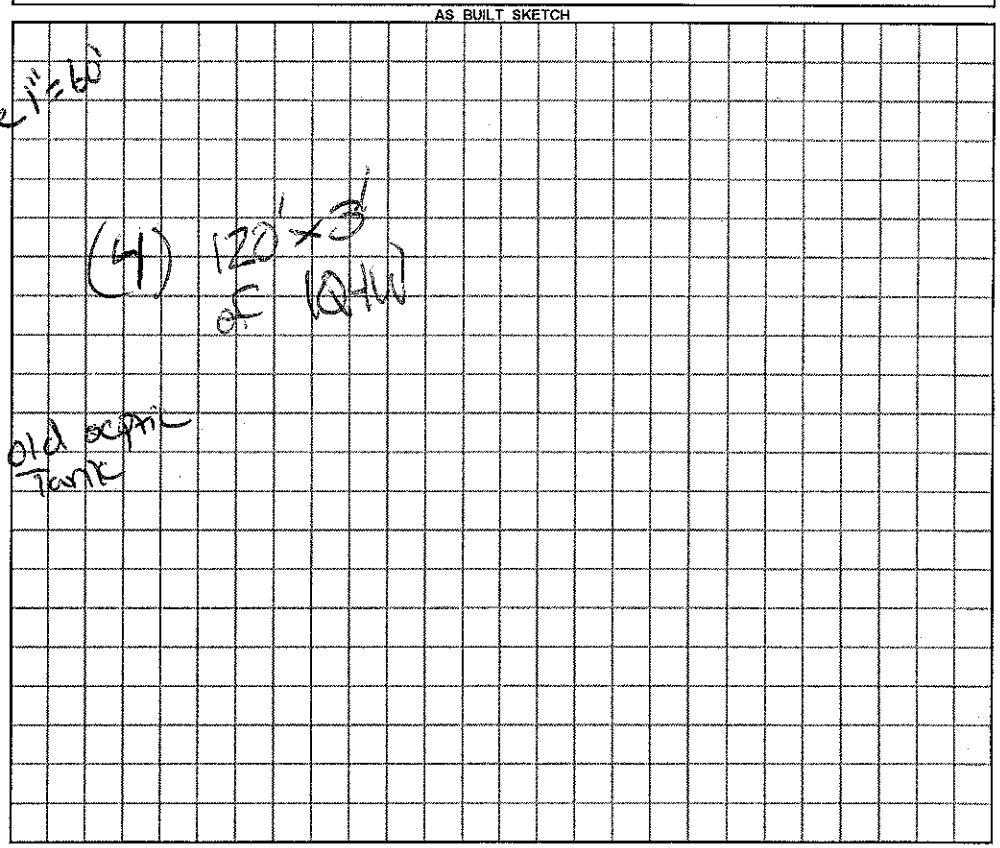

Permit can be suspended or revoked if any false information is supplied toward securing the permit / any unauthorized changes are made to the site / any unauthorized changes are made in the installation of the system.

☐ ***IMPROVEMENT PERMIT*** with plat valid without expiration. ☑ ***IMPROVEMENT PERMIT*** with plat valid without expiration. site plan valid 60 mo. ☑ ***AUTHORIZATION TO CONSTRUCT*** valid for period equal to IMPROVEMENT PERMIT--not to exceed 60 mo.

Owner / Applicant Signature: [signature] Date 7/19/12 Installed by: David Younts

IMPROVEMENT PERMIT by: Justin Henderson REHS Date 7-19-12 OPERATION PERMIT by: [signature] REHS Date 7-30-12

AUTHORIZATION TO CONSTRUCT by: Justin Henderson REHS Date 7-19-12 Existing System Inspected by: ____ REHS Date ____

YOU SHOULD CONTACT A LOCATOR SERVICE PRIOR TO ANY EXCAVATION

White Copy – Environmental Health YELLOW COPY (Final) Owner / Applicant PINK COPY (Initial) Owner / Applicant