IREDELL COUNTY HEALTH DEPARTMENT

STATESVILLE 704-878-5305 125.00 Paid MOORESVILLE 704-664-5281

IMPROVEMENT PERMIT / AUTHORIZATION TO CONSTRUCT / OPERATION PERMIT / EXISTING SYSTEM INSPECTION

PERMIT# 103125 PIN# ~~4753-52-0076.3~~ 4753-41-5850 DATE Dec 21, 01

OWNER OR CONTRACTOR M.B. Cline PHONE: Business _____ Home _____

ADDRESS 141 Cedarlake Dr. Statesville

LOCATION 70 EAST TR Third Creek Rd. on left at jct w/ Morning Dew Dr.

SUBDIVISION Third Creek PLACE BLOCK / SECTION 1 LOT 3 LOT AREA .536 Ac SITE CLASS. B DESIGN FLOW 360 gpd L.T.A.R. .3

Septic Tank: 1000 Gallons; STB 825 Date 01/04/03
Pump Tank: _____ Gallons; PT _____ Date _____
Pump Make: _____ Model _____ Serial No. _____
Nitrification Field: No Fields 1 Square Feet 900 Linear Feet 300
No Lines 4@75' Trench Width 36" Max Trench Bottom Depth 36" Gravel Depth NA

☑ New System ☐ Repair System Type: I, II, (III), IV, V, VI
System Description: Gravity Innovative -25% Red.
Repair System Description: Conv/LP PPBPS
Maintenance Agreement Required: ☐ Yes ☑ No initially
☐ Slab ☑ Crawl Space ☐ Basement w/plumbing ☐ Basement wo/plumbing

☐ House/Mod. Home No. Bedrooms 3
☐ Mobile Home No. Bathrooms 2
☐ Business No. Employees _____
☐ Other _____

Water Supply:
☐ Individual
☑ Public
☐ Community


Comments:/Conditions:

Remove (shaveoff) old burn KEEPING SIDE ENTRY GARAGE
* FLIP FLOP PLANS, KEEP DRIVEWAY SAME, ~~[illegible]~~

Comments:/Conditions:

1"=50'

INITIAL SITE SKETCH

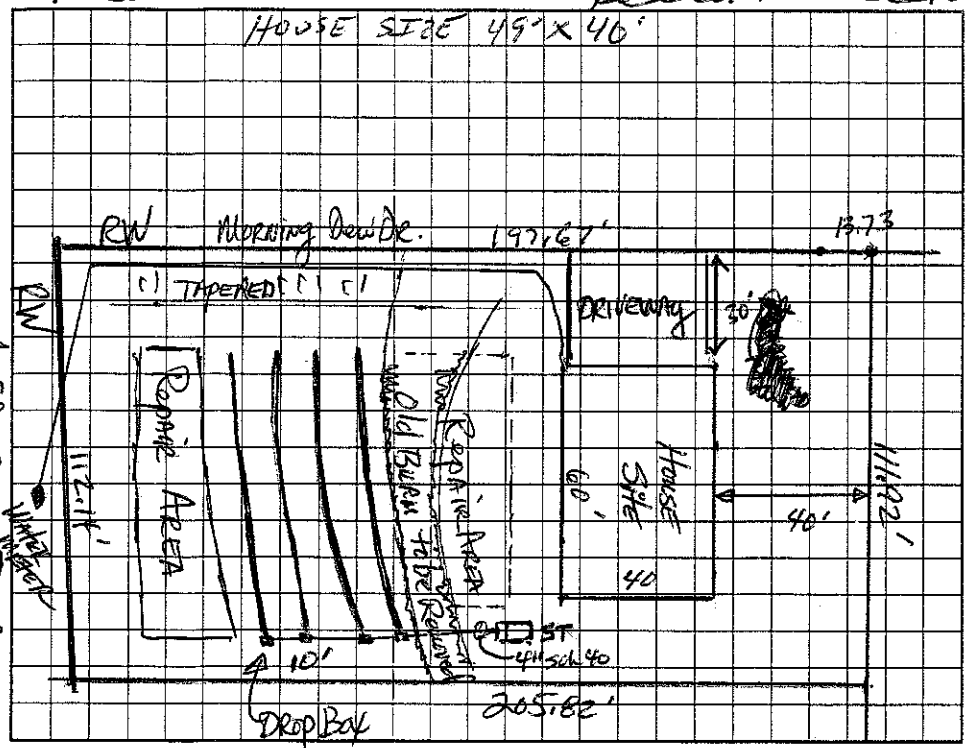

AS BUILT SKETCH

* SYSTEM INSTALLED AS SHOWN IN INITIAL SITE SKETCH.

Permit can be suspended or revoked if any false information is supplied toward securing the permit/any unauthorized changes are made to the site/any unauthorized changes are made in the installation of the system. Improvement Permit with plat valid without expiration. Improvement Permit with site plan valid for sixty months. Authorization to Construct is valid for a period equal to that of Improvement Permit – not to exceed sixty months.

Signed: MB Cline date 1-31-02
Improvement Permit by: [signature] RS date 12-21-01
Authorization to Construct by: [signature] RS date 02-27-02

Installed by: ROWAN SEPTIC - 03/25/03
Operation Permit by: Patrick Mitchell date 03/26/03
Existing System Inspection by: _____ date _____

HEALTH DEPT. COPY: WHITE OWNER COPY (FINAL): YELLOW OWNER COPY (INITIAL): PINK