*THIS PERMIT VOIDS PERMIT ISSUED 01/04/02.

IREDELL COUNTY HEALTH DEPARTMENT

STATESVILLE 704-878-5305 MOORESVILLE 704-664-5281

IMPROVEMENT PERMIT / AUTHORIZATION TO CONSTRUCT / OPERATION PERMIT / EXISTING SYSTEM INSPECTION

PERMIT# 103123 PIN# 4753-52-0076 4753-42-5067 DATE 03/10/03

OWNER OR CONTRACTOR M.B. CLINE PHONE: Business _____ Home _____

ADDRESS 141 CEDAR LAKE DR. STATESVILLE, NC MAX SPEARS 704-202-4964

LOCATION HWY 70 EAST, (R) THIRD CREEK RD, PROPERTY ON LEFT.

SUBDIVISION THIRD CREEK BLOCK / SECTION 1 LOT 1 LOT AREA 0.535 ACRES SITE CLASS. PS DESIGN FLOW 360 GPD L.T.A.R. 0.30 GPD/FT²

Septic Tank: 1,000 Gallons; STB 825 Date 01/08/03
Pump Tank: _____ Gallons; PT _____ Date _____
Pump Make: _____ Model _____ Serial No. _____
Nitrification Field: No Fields 1 Square Feet EQ to 1,200 Linear Feet 300
No Lines 6 @ 50' Trench Width 36" Max Trench Bottom Depth 36" Gravel Depth N/A

[X] New System [ ] Repair System Type: I, II, (III), IV, V, VI
System Description: 25% REDUCTION, GRAVITY
Repair System Description: 50% REDUC., LOW PRESSURE
Maintenance Agreement Required: [ ] Yes [X] No

[X] House/Mod. Home No. Bedrooms 3
[ ] Mobile Home No. Bathrooms 2
[ ] Business No. Employees ____
[ ] Other _____


[ ] Slab [X] Crawl Space [ ] Basement w/plumbing [ ] Basement wo/plumbing

Water Supply: [ ] Individual [X] Public [ ] Community

Comments/Conditions: (1) INSTALL SYSTEM AS SHOWN USING 1 FLOW DIVIDER "T" AND 2 DISTRIBUTION BOXES WITH FLOW DIVIDER "T"s,

Comments/Conditions: -SEPTIC TANK INSTALLED USING POLY-LOC-FILTER & TANK MARKER,

INITIAL SITE SKETCH

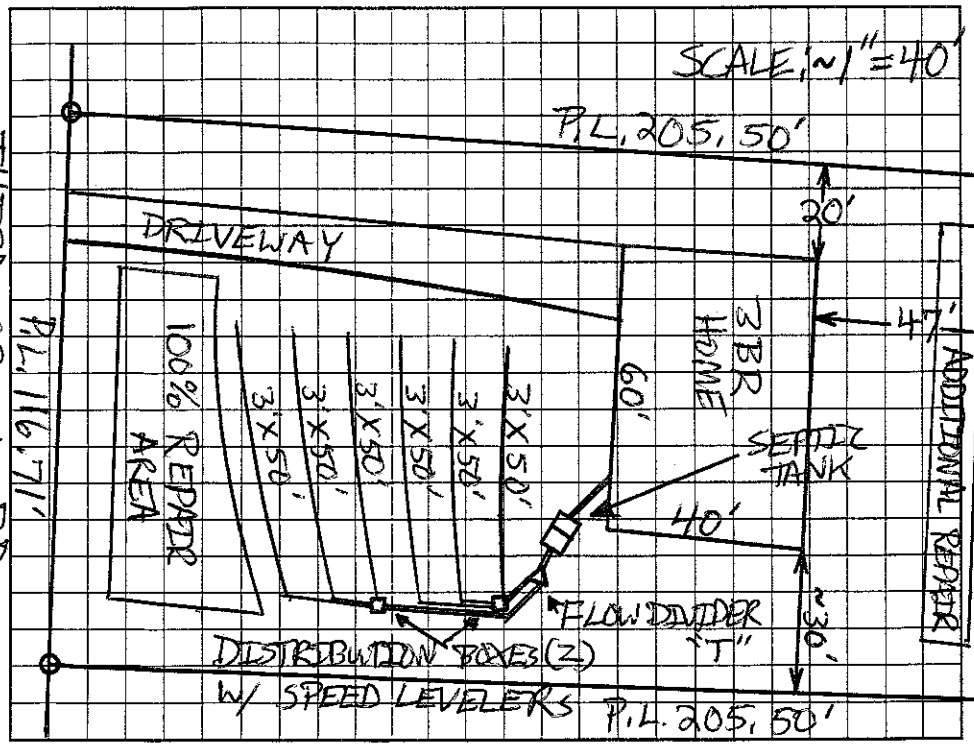

AS BUILT SKETCH

*SYSTEM INSTALLED AS SHOWN IN INITIAL SITE SKETCH,

Permit can be suspended or revoked if any false information is supplied toward securing the permit/any unauthorized changes are made to the site/any unauthorized changes are made in the installation of the system. Improvement Permit with plat valid without expiration. Improvement Permit with site plan valid for sixty months. Authorization to Construct is valid for a period equal to that of Improvement Permit – not to exceed sixty months.

Signed: _____ date 3/10/03 Installed by: ROWAN SEPTIC 03-13-03

Improvement Permit by: Patrick Mitchell date 03/10/03 Operation Permit by: Patrick Mitchell date 03/13/03

Authorization to Construct by: Patrick Mitchell date 03/10/03 Existing System Inspection by: _____ date _____

HEALTH DEPT. COPY: WHITE OWNER COPY (FINAL): YELLOW OWNER COPY (INITIAL): PINK