IREDELL COUNTY HEALTH DEPARTMENT

Statesville Phone TR 3-7271 . Mooresville Phone No. 664-5281

PERMIT TO INSTALL SEPTIC TANK

Permit No. _____ Permit Date 9-21 19 73

Owner Ireenhour Bldg. Co. Address Statesville, NC

Installed By Tommy Howe Ireenhour Bldg. Co. Address Statesville, NC


Location of Property Highway 70 E Right on Rd # 2354 & 1 mile House on left. Lot #1

Tank		Capacity		Length of Lines		Fixtures	
Block	( )	1000	( )	225'	( )	No. of Baths	(2)
Precast	(✓)	1250	(✓)	250'	( )	Dishwasher	(✓)
		1500	( )	Other 256'	(✓)	Garbage Grdr.	(✓)
		Other				Other	

NOTIFY HEALTH DEPARTMENT AT LEAST EIGHT HOURS BEFORE TANK IS TO BE INSPECTED.

Final Inspection 9-21 19 73 Approved (✓) Disapproved ( )

Remarks WATER Supply - City of Statesville

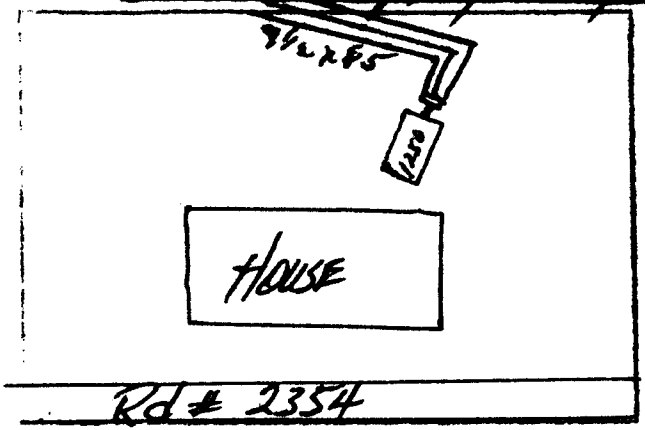

Sketch of Installation

Glenn Fox Jr.
Sanitarian