IREDELL COUNTY HEALTH DEPARTMENT

STATESVILLE 704-878-5305 MOORESVILLE 704-664-5281

IMPROVEMENT PERMIT / AUTHORIZATION TO CONSTRUCT / OPERATION PERMIT / EXISTING SYSTEM INSPECTION

PERMIT# Repair PIN#

OWNER OR CONTRACTOR Anna Pettit DATE 2-12-99

ADDRESS PO Box 132 Barium Springs 28010 PHONE: Business Home 873-0342

LOCATION 217 Third Creek Rd - TOE TR Third Creek

SUBDIVISION BLOCK / SECTION LOT LOT AREA SITE CLASS DESIGN FLOW L.T.A.R.

Septic Tank: 1500 Gallons; STB 10/11 Date 1-11-99
Pump Tank: Gallons; PT Date
Pump Make: Model Serial No.
Nitrification Field: No Fields Square Feet Linear Feet
No Lines Trench Width Max Trench Bottom Depth Gravel Depth

☐ New System ☒ Repair System Type: I. II. III. IV. V. VI
System Description:
Repair System Description: Tank Replacement
Maintenance Agreement Required: ☐ Yes ☐ No

☐ House/Mod. Home No. Bedrooms 6
☐ Mobile Home No. Bathrooms 2
☐ Business No. Employees
☒ Other Duplex


☐ Slab ☐ Crawl Space ☐ Basement w/plumbing ☐ Basement wo/plumbing

Water Supply:
☐ Individual
☒ Public
☐ Community


Comments/Conditions:
Replace existing tank with new 1500 gal Tank
Pump & fill in old Tank

Comments/Conditions

INITIAL SITE SKETCH

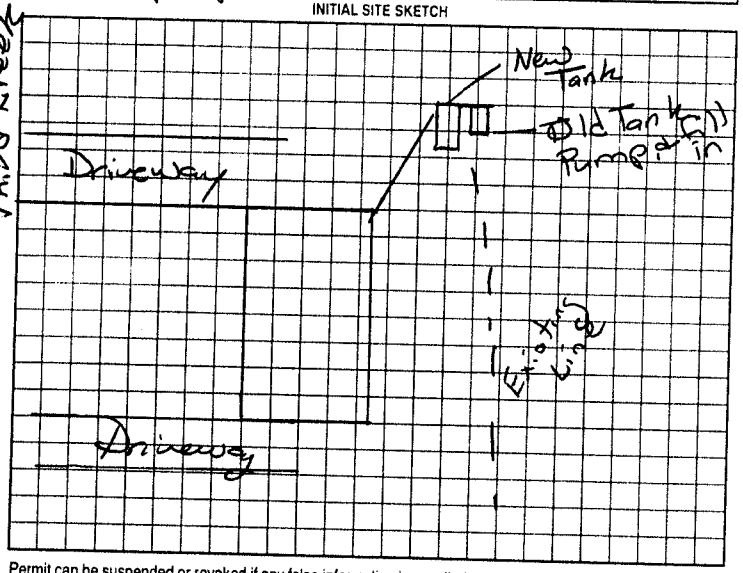

AS BUILT SKETCH

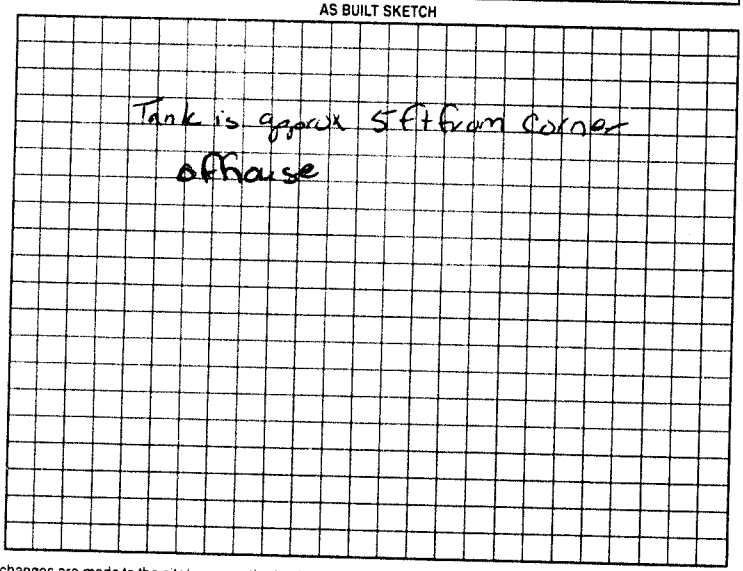

Permit can be suspended or revoked if any false information is supplied toward securing the permit/any unauthorized changes are made to the site/any unauthorized changes are made in the installation of the system. Improvement Permit with plat valid without expiration. Improvement Permit with site plan valid for sixty months. Authorization to Construct is valid for a period equal to that of Improvement Permit - not to exceed sixty months.

Signed: Anna G. Pettit date

Improvement Permit by: M C Ott RS date 2-12-99

Authorization to Construct by: M C Ott RS date 2-12-99

Installed by: Steve Jordan

Operation Permit by: M C Ott RS date 2-26-99

Existing System Inspection by: date

HEALTH DEPT COPY WHITE OWNER COPY (FINAL) YELLOW OWNER COPY (INITIAL) PINK